


TOWN OF LEXINGTON — BOARD OF PUBLIC WORKS
SEWER DIVISION

Sketch of Service Here

48

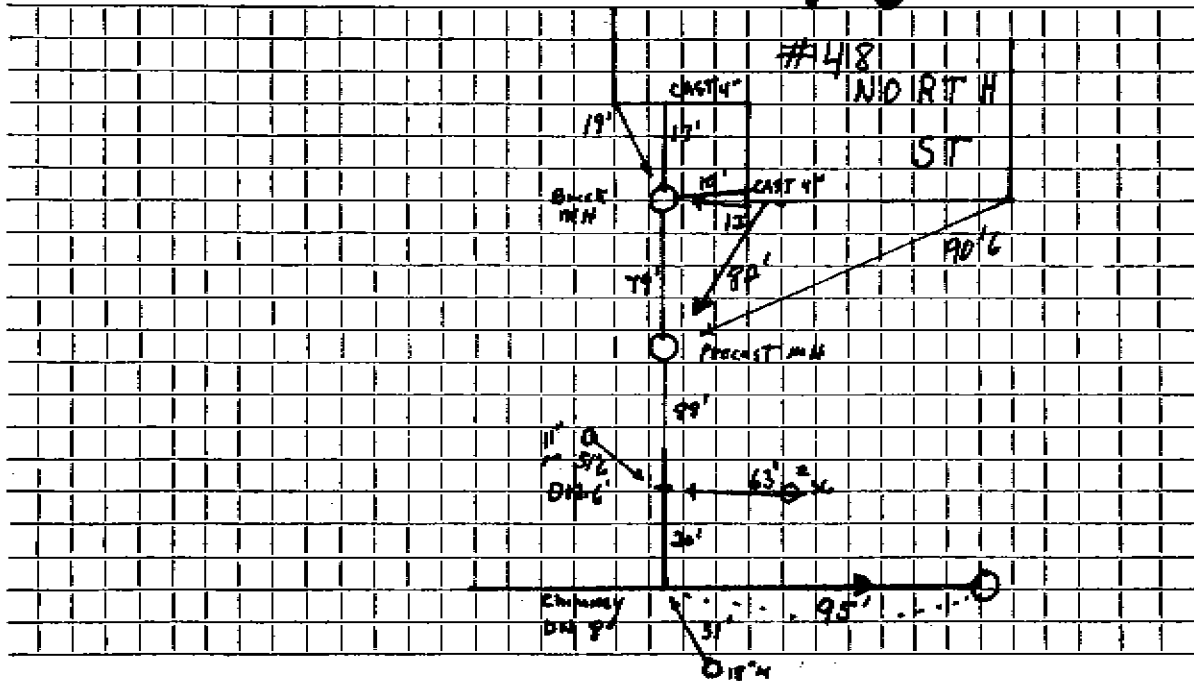

Connection made in North St. Street. Work completed

Remarks: