




DATE 10/28/83

TOWN OF LEXINGTON — BOARD OF PUBLIC WORKS  
SEWER DIVISION

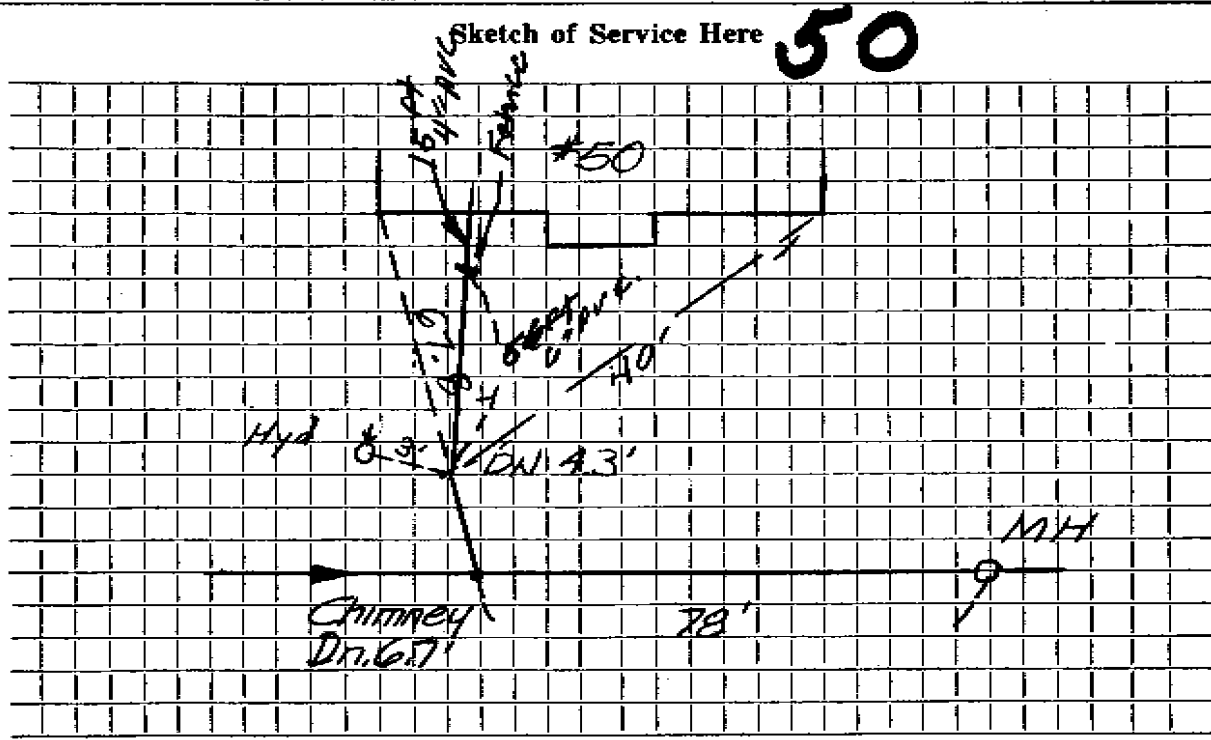

Connection made in ... NORTH ... Street. Work completed .....

Remarks: .....  
.....  
.....