


DATE 5/23/96

TOWN OF LEXINGTON — BOARD OF PUBLIC WORKS
SEWER DIVISION

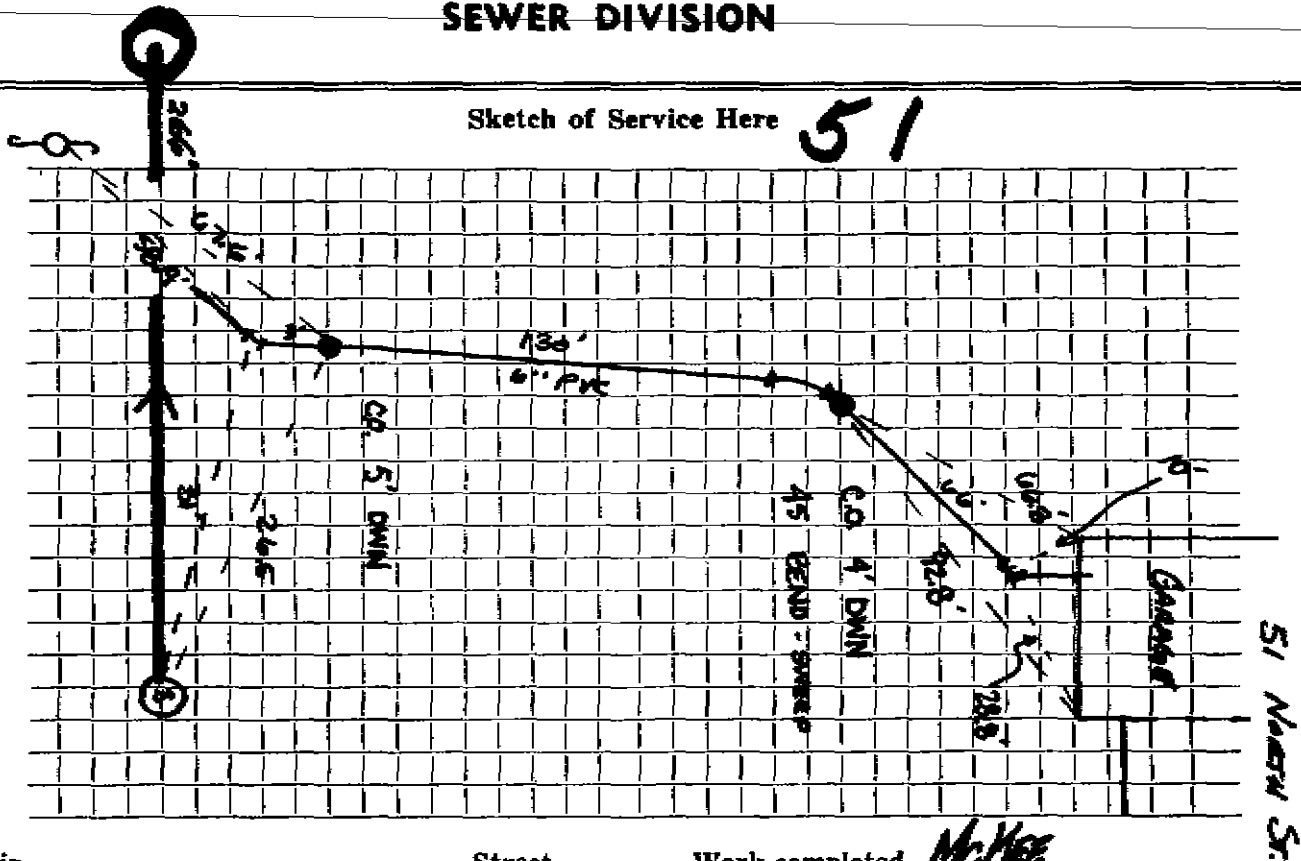

Connection made in Street. Work completed McH...

Remarks:

.....

.....