


DATE 10/28/03

TOWN OF LEXINGTON — BOARD OF PUBLIC WORKS
SEWER DIVISION

Sketch of Service Here **52**

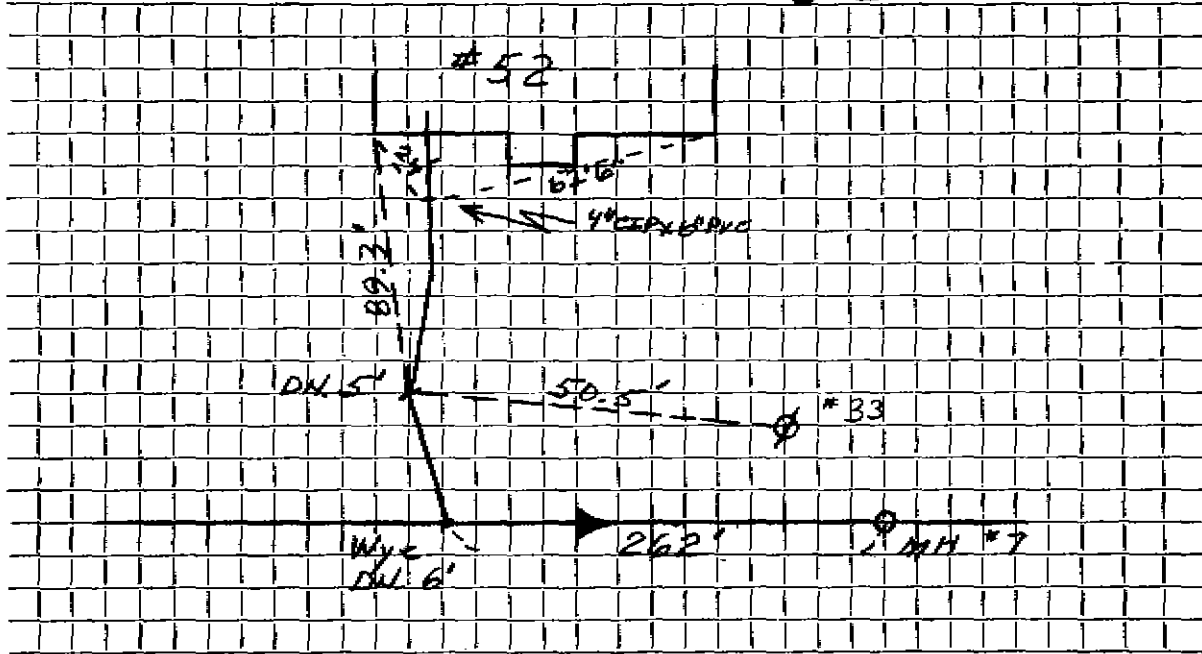

Connection made in North St. Street. Work completed Dec 1, 1903

Remarks: