

Name

Service No.

Address

54 North St

Location

Kind of Pipe

Size

Size of Main

~~Repair~~

~~Renewal~~

New Service

Location

Date

Material

Amount

Total

Date

Amount


7-8-08

6x6x6 WYE Clean out  
20' 6" PVC  
2-22° BENDS

DATE \_\_\_\_\_

**TOWN OF LEXINGTON — BOARD OF PUBLIC WORKS**  
**SEWER DIVISION**

Sketch of Service Here

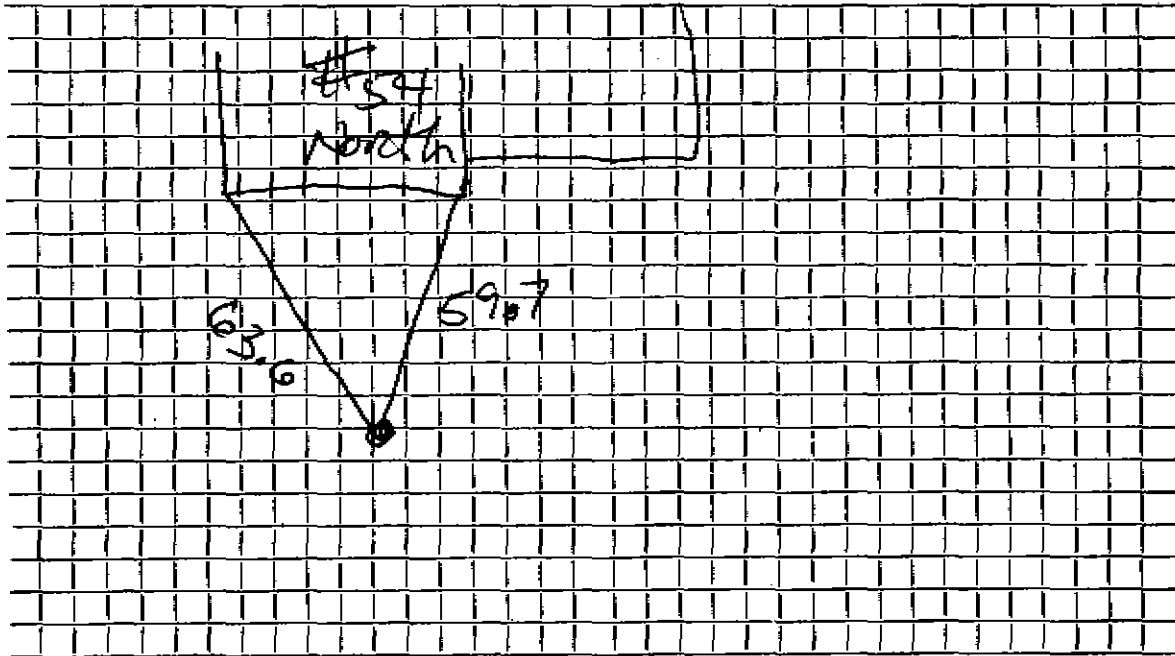

Connection made in ..... Street.      Work completed .....

Remarks: .....  
.....  
.....