


DATE 11-8-83

TOWN OF LEXINGTON — BOARD OF PUBLIC WORKS

SEWER DIVISION

Sketch of Service Here

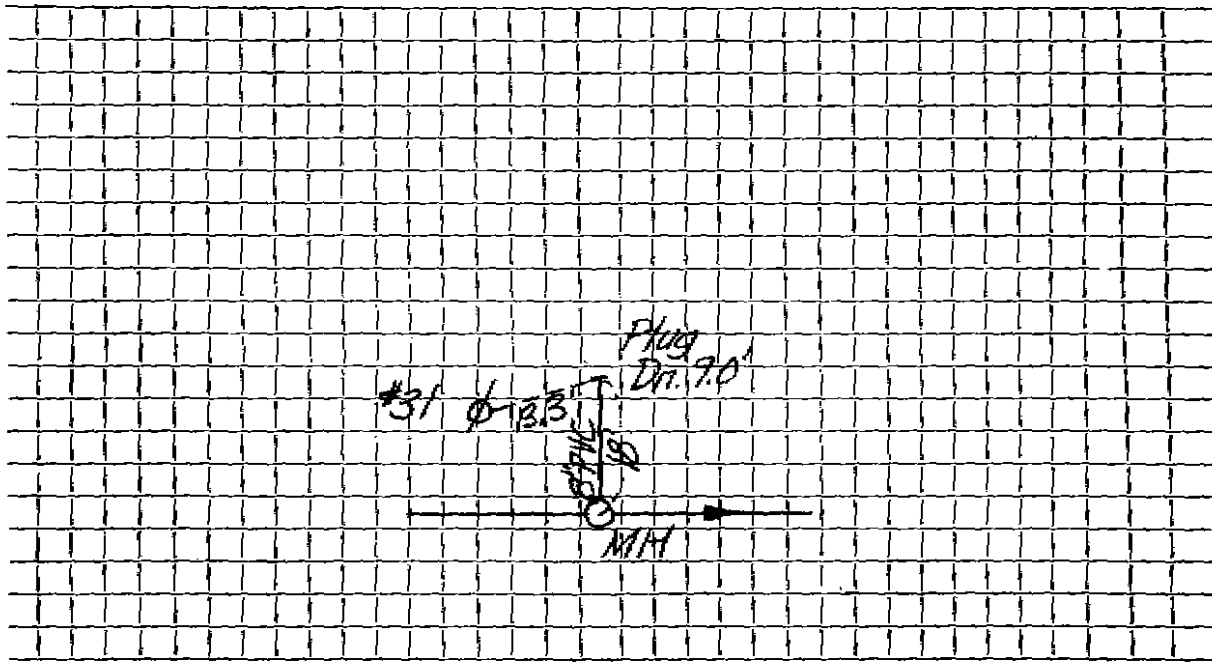

Connection made in North St. Street. Work completed

Remarks:
.....
.....