

Name

Barry Couette

Service No.

Address 58 NORTH ST.

58 North St.

Location

Kind of Pipe PVC

Size 6"

Size of Main 8"

Repair--Renewal--New Service

McLaughlin #0189

Location

Date

10/30/92

Material

7 L.F. of 4" PVC

83 L.F. of 6" PVC

22° BEND

SMH

4" X 6" PEENCO

Amount

Total

Date


Amount

DATE 6/30/92

TOWN OF LEXINGTON — BOARD OF PUBLIC WORKS
SEWER DIVISION

Sketch of Service Here

58

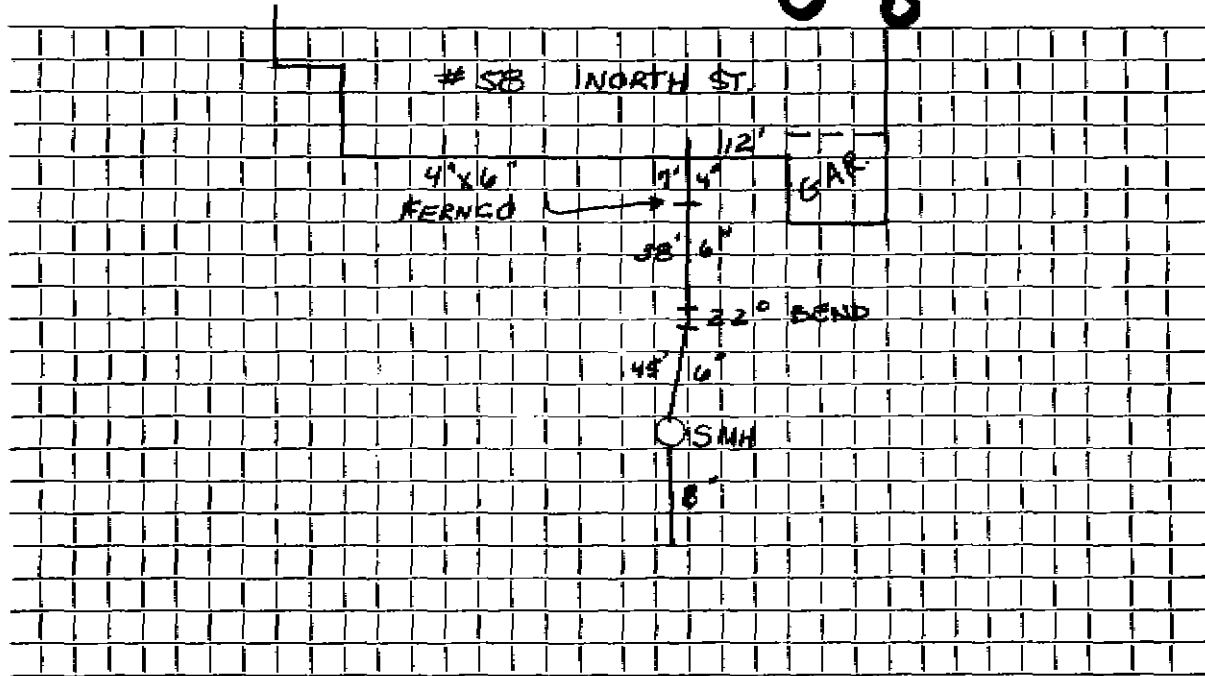

Connection made in NORTH Street. Work completed

Remarks: INSTALLED BY: J. McLAUGHLIN

INSPECTED BY: C.R.G.