

Name JUDITH FLAGG

Service No.

Address #70 NORTH STREET

70 North St.

Location

Kind of Pipe

Size 6"

Size of Main 8"

Repair—Renewal—New Service

SEPTIC ABANDONMENT - PERMIT 0876 - ARLEX


Location

Date	Material	Amount	Total	Date	PUMP CHASER DETAIL	Amount
10/4 96	SEE CARD FOR DETAILS					
73 6" PVC				7-27-83		
					20.5' - 6" DIA	
					1 6" X 8" Wye	

DATE 4 OCTOBER 1996

TOWN OF LEXINGTON — BOARD OF PUBLIC WORKS
SEWER DIVISION

Sketch of Service Here **70**

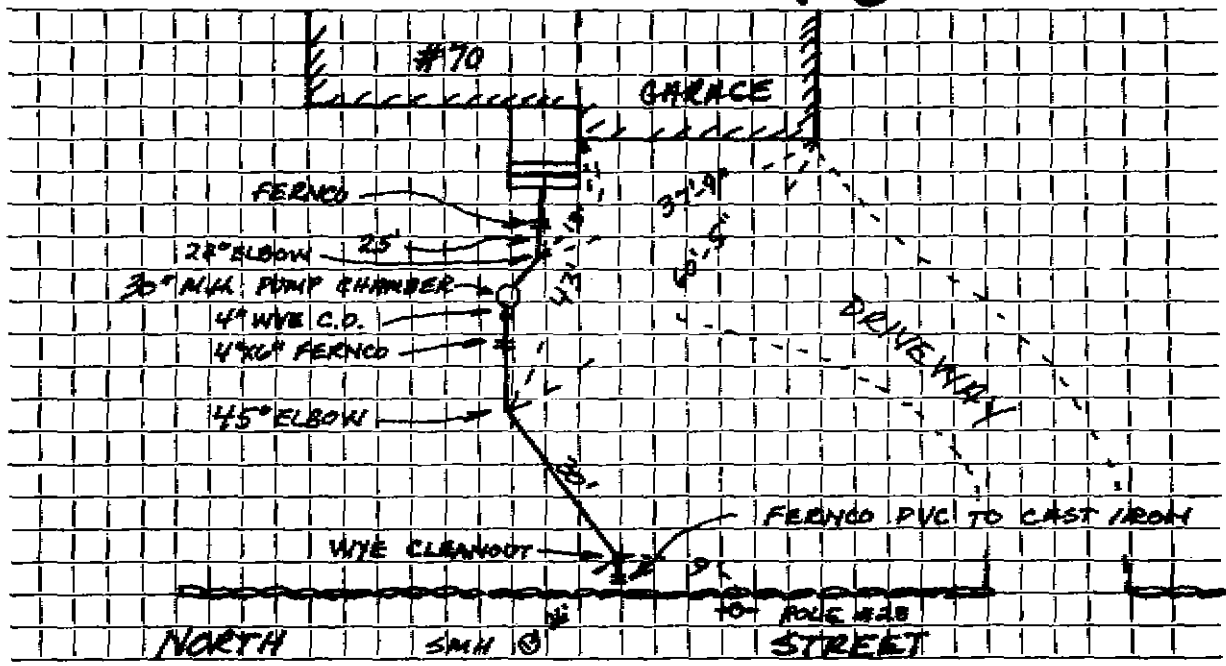

Connection made in NORTH STREET Street.

Work completed ARLEX OIL COMPANY

Remarks: