


DATE 6/9/88

TOWN OF LEXINGTON — BOARD OF PUBLIC WORKS
SEWER DIVISION

Sketch of Service Here **78**

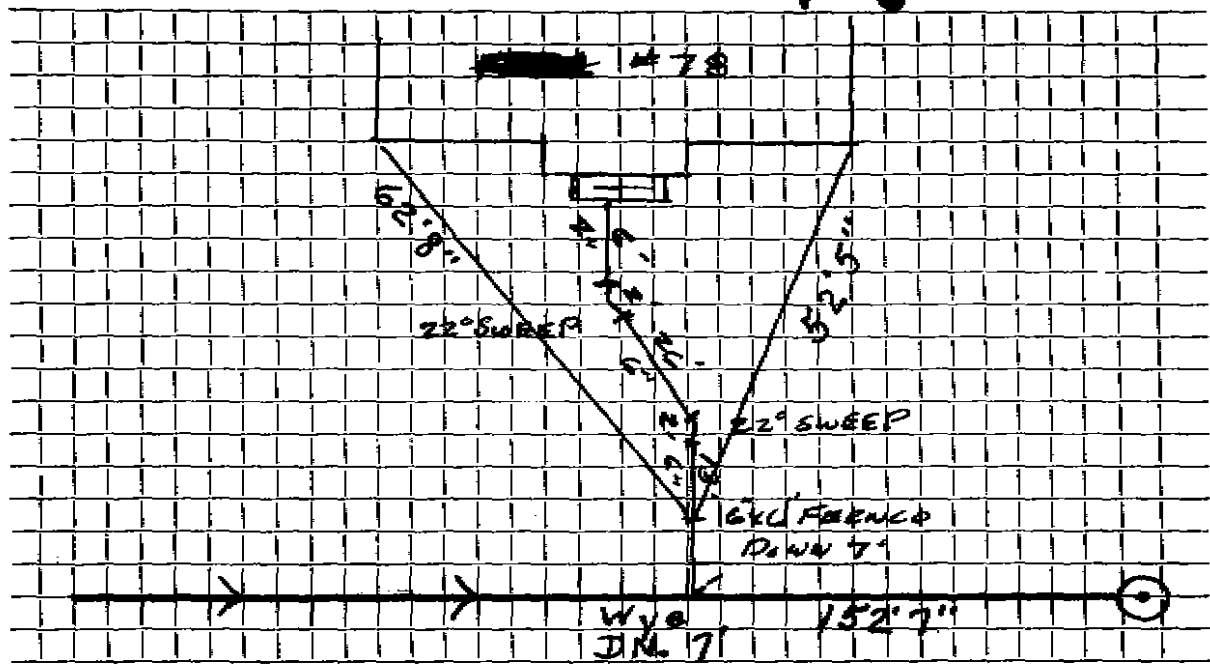

Connection made in NORTH Street. Work completed

Remarks: