


DATE 7/7/92

TOWN OF LEXINGTON — BOARD OF PUBLIC WORKS
SEWER DIVISION

Sketch of Service Here

8

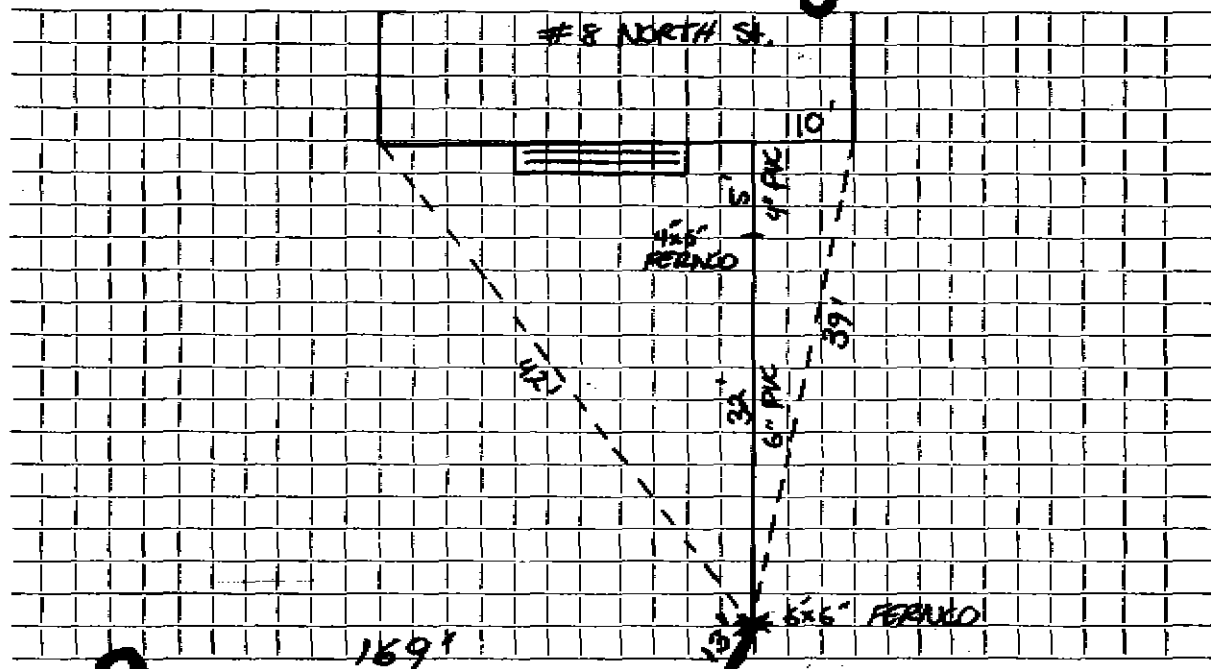

Connection made in G Street. Work completed

Remarks: INSTALLER BY: B. MCKEE
INSPECTED BY: C. GALJAARD