

Name William Simmons

Service No.

Address 82 North Street

82 North St.

Location

Kind of Pipe PVC

Size 6"

Size of Main 8"

Repair—Renewal—New Service Redmond #526

Location


Date		Material	Amount	Total	Date		Amount
8/27/73	23'	A.C. @ \$8.90		204.70	9-8-75	<i>Paid</i>	214.70
9/19/75	69.5'	6" Transite Pipe					
	10'	4" Cast Iron pipe					
		RELOCATION					
4/10/90	24'	6" PVC					
	13'	4" PVC					
		6" x 6" Reducer (Fernco)					
		6" x 4" Reducer (Fernco)					
		4" Wye					
		4" 45° Bend					
		4" Cleanout					

DATE 4/10/90

TOWN OF LEXINGTON — BOARD OF PUBLIC WORKS P.A.B.

SEWER DIVISION

Sketch of Service Here 82

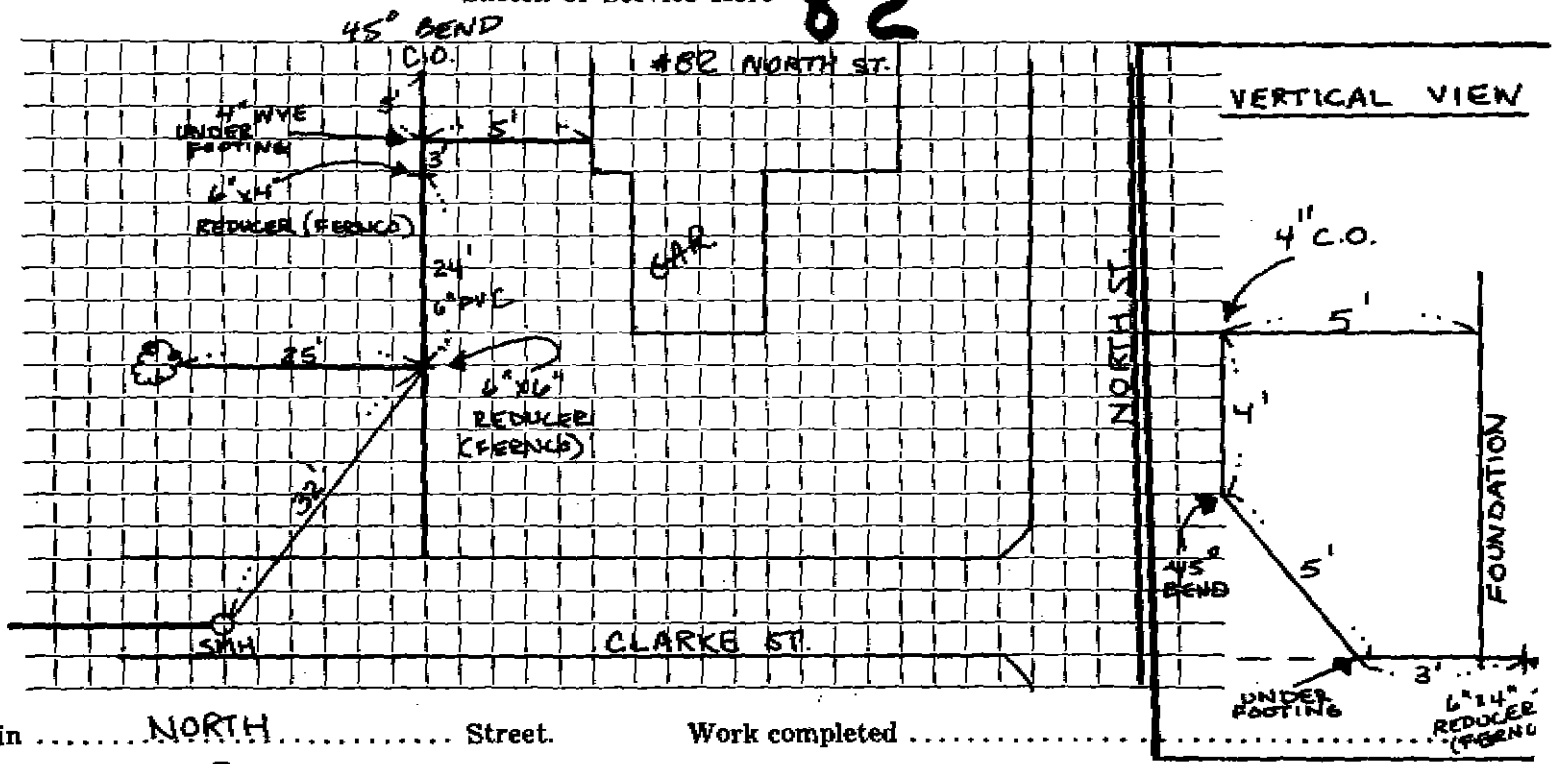

Connection made in NORTH Street.

Work completed

Remarks: INSPECTED: P.A. BARRONS

CONTRACTOR: J. REDMAN