


DATE _____

TOWN OF LEXINGTON — BOARD OF PUBLIC WORKS

SEWER DIVISION

Sketch of Service Here

84

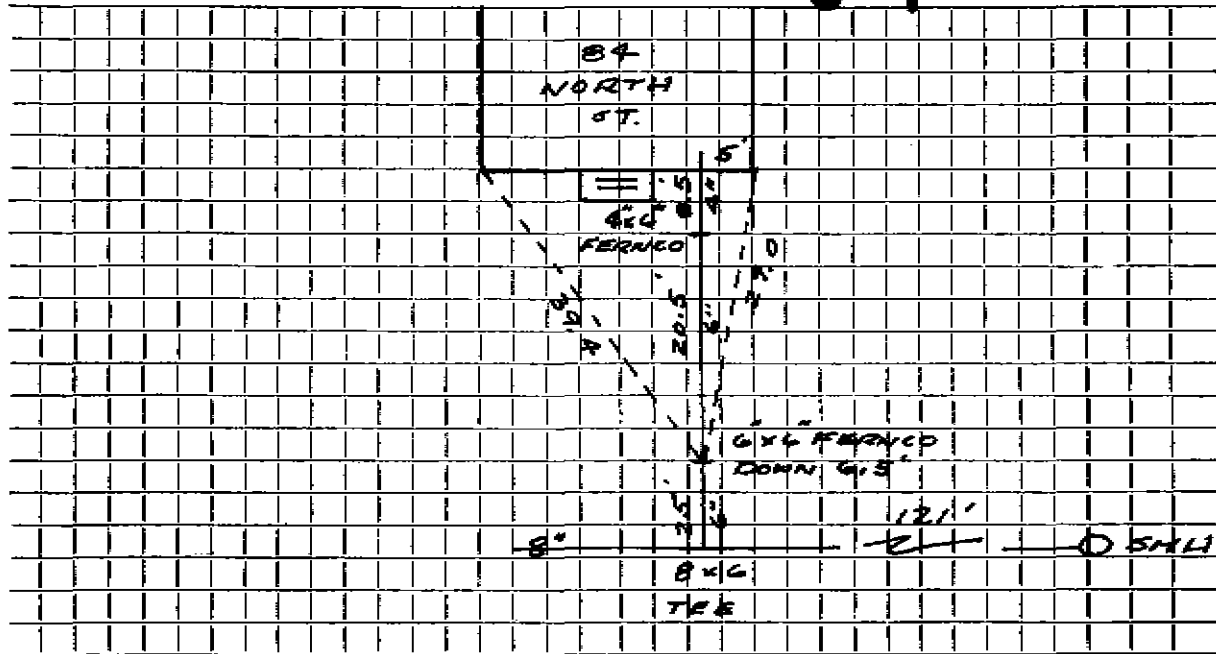

Connection made in NORTH Street. Work completed

Remarks: B. MCKEE CONTR.