

Name **Marie Eberle**

Service No. **20**

Address **85 North Street**

**85 North St.**

Location Lot #7

Kind of Pipe

Size **6"**

Size of Main **8"**

~~Remarks~~ **New Service McKee #4997**

Location

Date	Material	Amount	Total	Date	Amount
<del>1969</del>	<del>13' 6" transit pipe</del>	<del>@ 8.00</del>		<del>5-21-87</del>	<del>104.00</del>
128/87	42' 6" PVC		\$ 104 00		Deposit
	8½' 4" PVC			12- -69	
	4" x 6" Fernco			13' 6" Transit	
				1 6" x 8" Wye	


DATE \_\_\_\_\_

# TOWN OF LEXINGTON — BOARD OF PUBLIC WORKS

## SEWER DIVISION

Sketch of Service Here

85

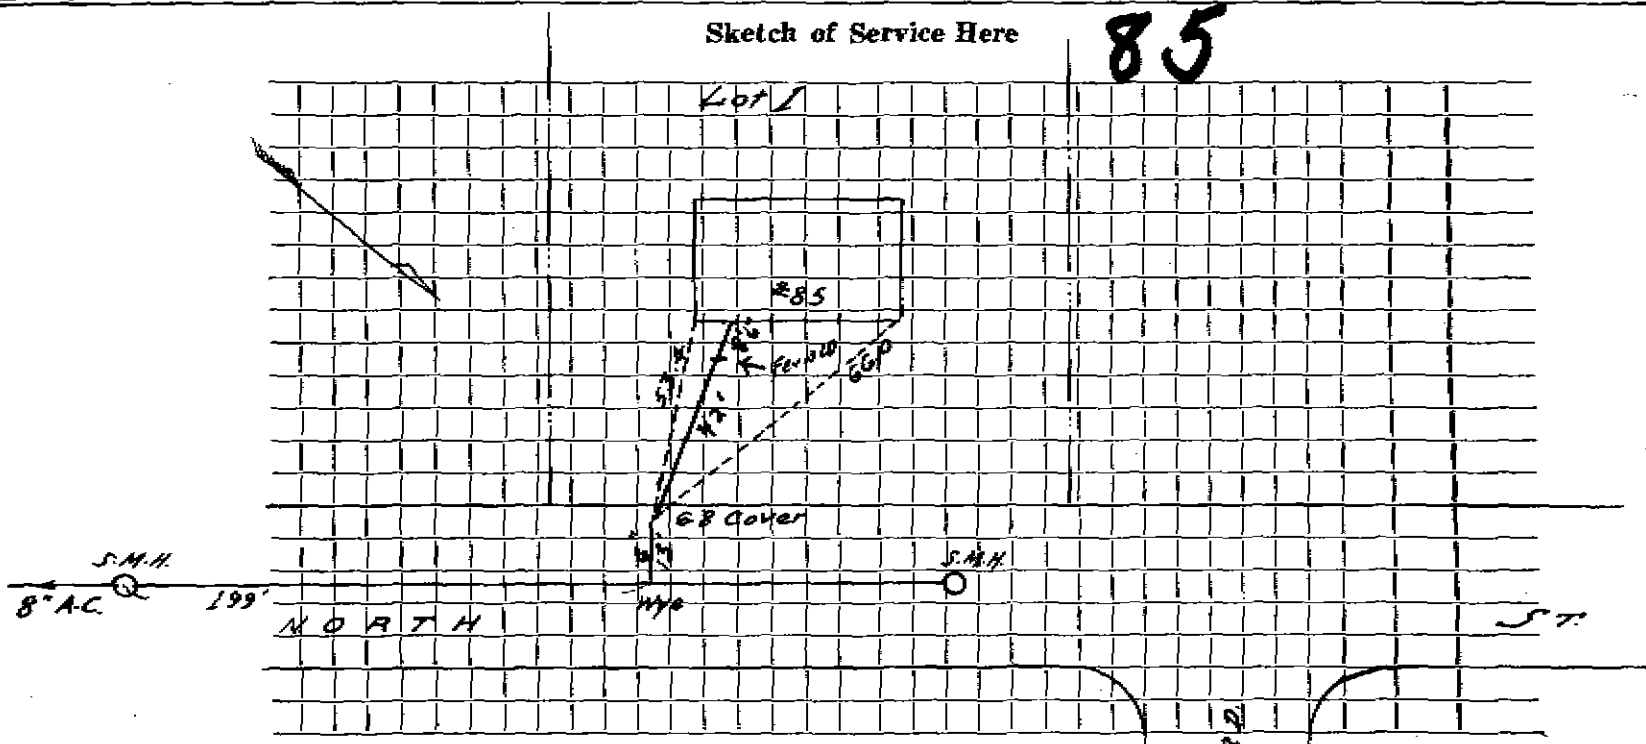

Connection made in ..... Street. Work completed .....

Remarks: *Water same trench 5' deep*

.....  
.....

CARL RD