


DATE _____

TOWN OF LEXINGTON — BOARD OF PUBLIC WORKS

SEWER DIVISION

Sketch of Service Here

86

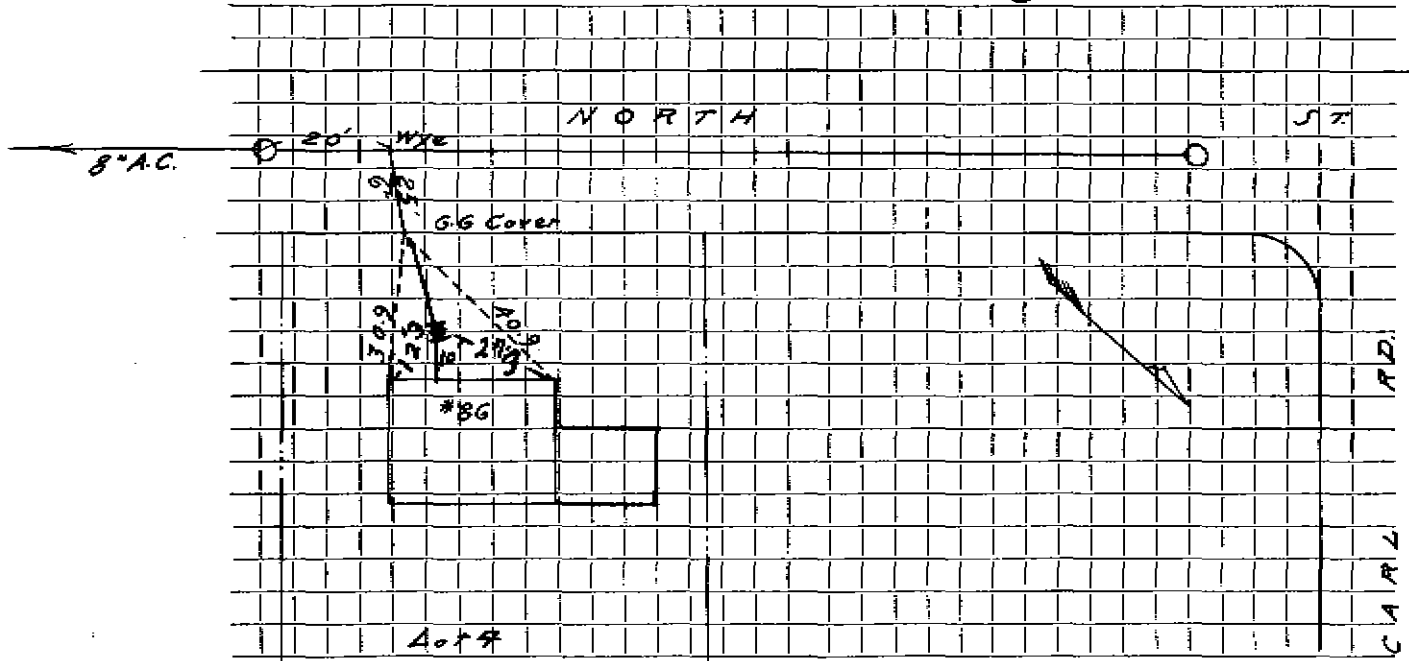

Connection made in _____ Street. Work completed 5/11/10

Remarks: Clean out 10' out from Foundation.