




DATE \_\_\_\_\_

# TOWN OF LEXINGTON — BOARD OF PUBLIC WORKS

## SEWER DIVISION

Sketch of Service Here

# 87

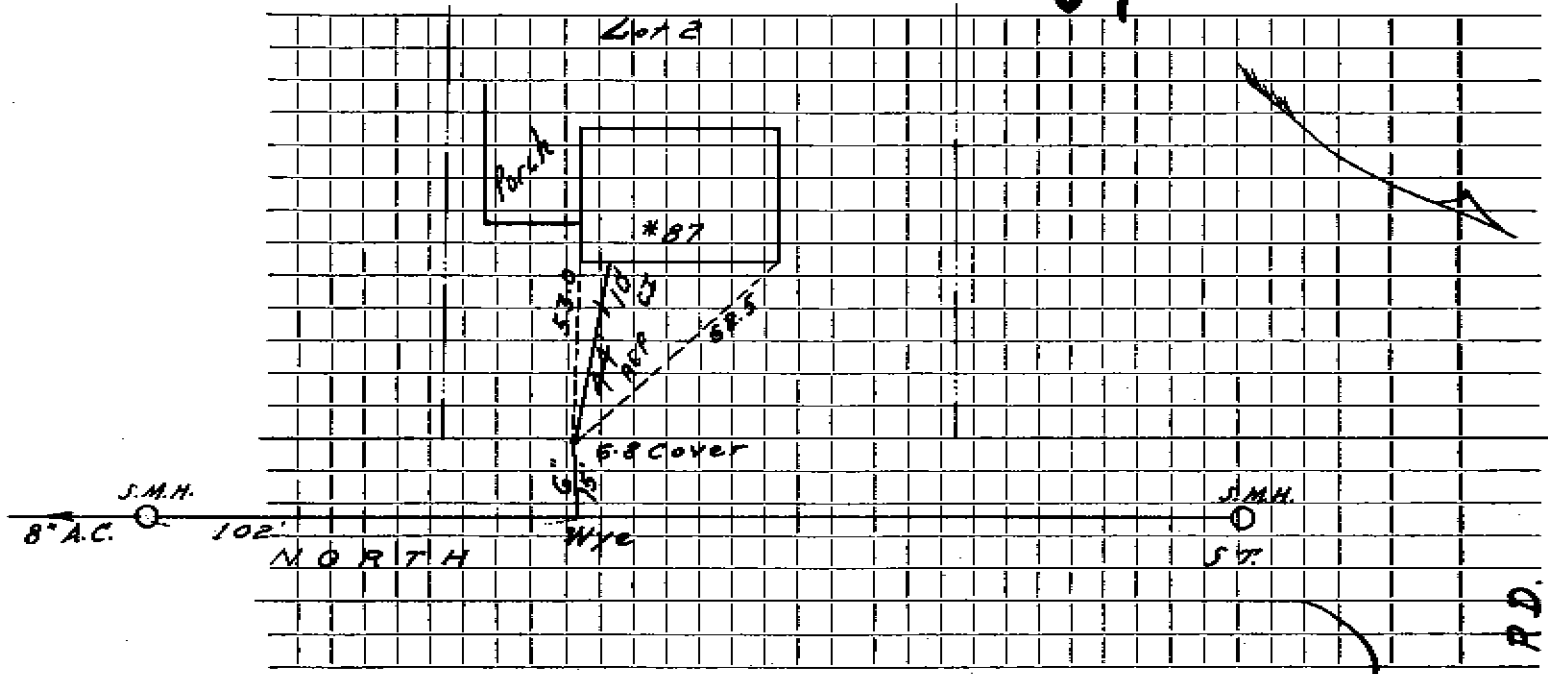

Connection made in ..... Street.

Work completed .....

Remarks: .....

.....  
.....

C.A.R.L. RD.