

Name

Service No.

Address 89 North Street

89 North ST.

Location Lot #3

Kind of Pipe

Size 6"

Size of Main 8"

Repair—Renewal—New Service

Location

Date	Material	Amount	Total	Date	Amount
10-1969	15' 6" transite pipe @ 8.00 -		\$ 120 00		
				12- -69	
				15' 6" Transite	
				1 6" x 8" Wye	
12/100	RENEW ALLEY				
	65' 6" PVC	1 6" WYE			
	1 22° BEND				
	1 C & G FERRICO				
	CLEAN OUT 2' FROM HOUSE				


DATE _____

TOWN OF LEXINGTON — BOARD OF PUBLIC WORKS

SEWER DIVISION

Sketch of Service Here

89

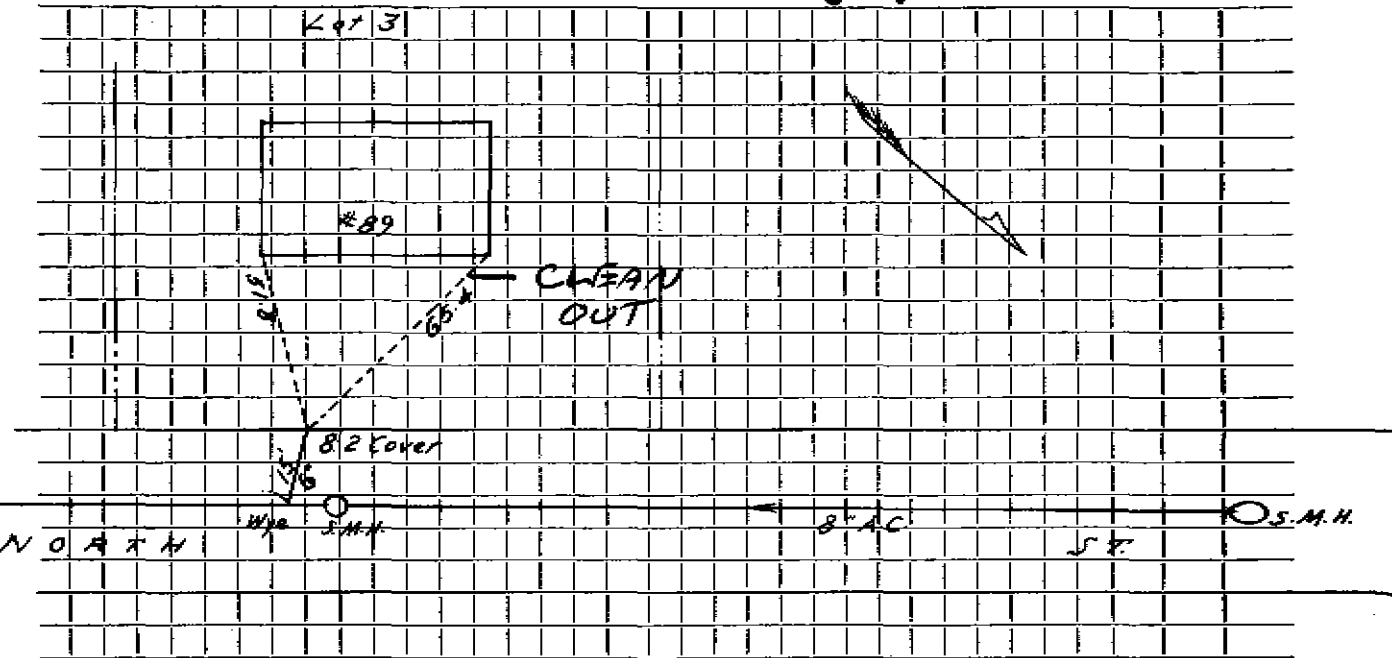

Connection made in Street. Work completed

Remarks:
.....
.....

CARL
RD.