


DATE _____

TOWN OF LEXINGTON — BOARD OF PUBLIC WORKS
SEWER DIVISION

Sketch of Service Here

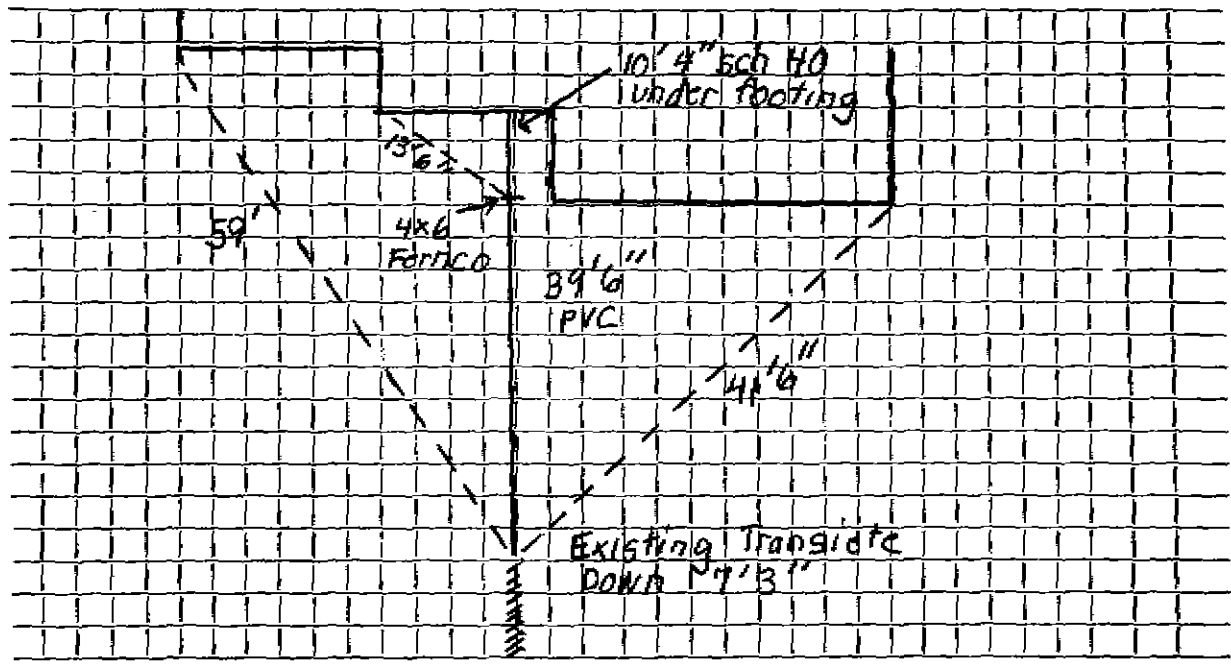

Connection made in Street. Work completed

Remarks:
.....
.....

Name **Jimmie R. Johnson**

Service No. **148**

Address **90 North Street**

Lot #3 **90 NORTH ST.** Location

Kind of Pipe

Size

Size of Main

Repair—Renewal—New Service **Lexington Sewerage #1519**

Location **APR 6 1970**

Date		Material	Amount	Total	Date		Amount
ov 169	21'	6" Transite pipe @8.00		192.00	12-3-69	<i>Deposit</i>	192 00
-10-69	23'	6" Transite pipe					
	10'	4" Cast Iron pipe			11- -69		
						24' 6" Transite	
						1 6" X 8" Wye	


6.18501

DATE _____

TOWN OF LEXINGTON — BOARD OF PUBLIC WORKS

SEWER DIVISION

Sketch of Service Here **90**

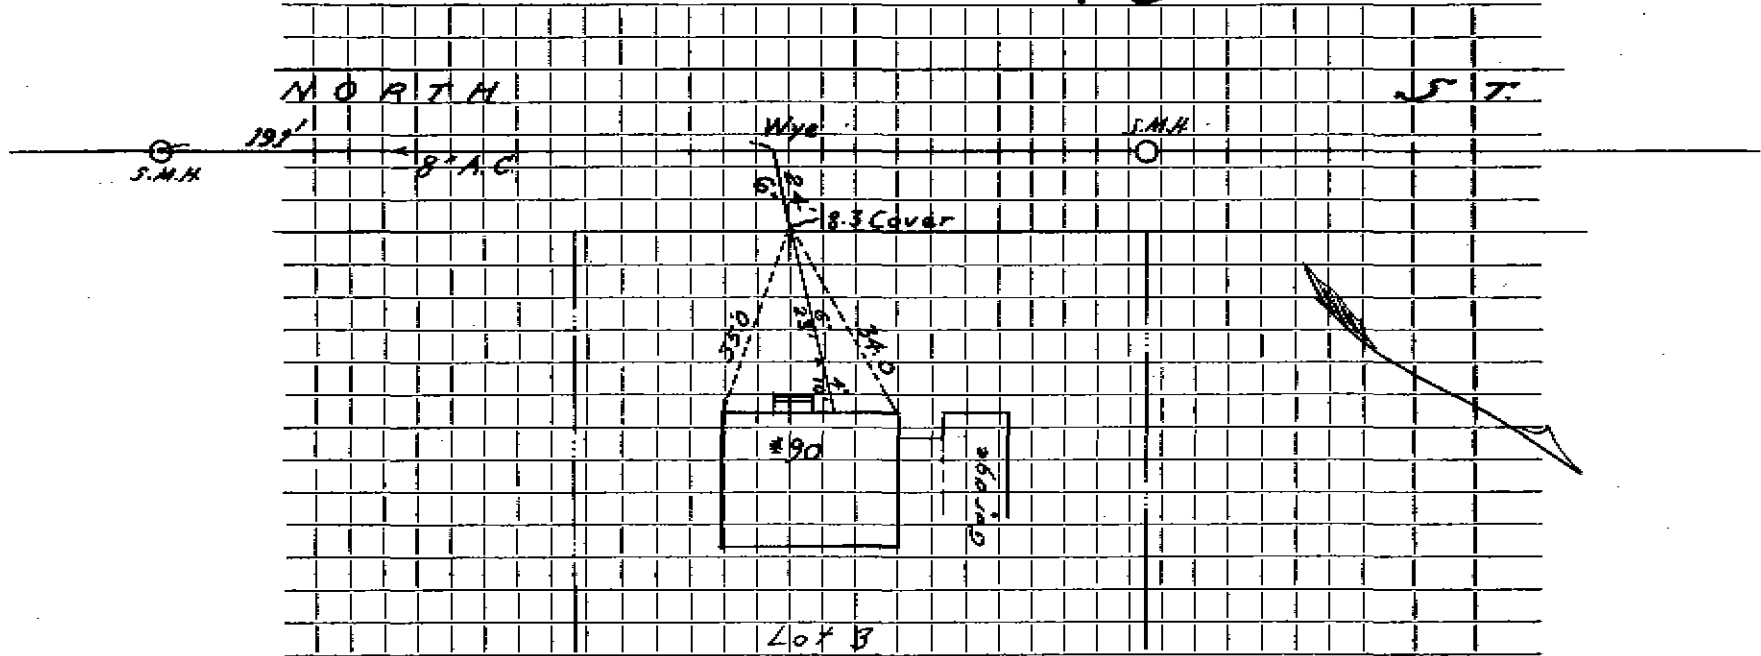

Connection made in Street. Work completed


Remarks:
.....
.....

DATE MAY 26 1899

TOWN OF LEXINGTON — BOARD OF PUBLIC WORKS

SEWER DIVISION

Sketch of Service Here

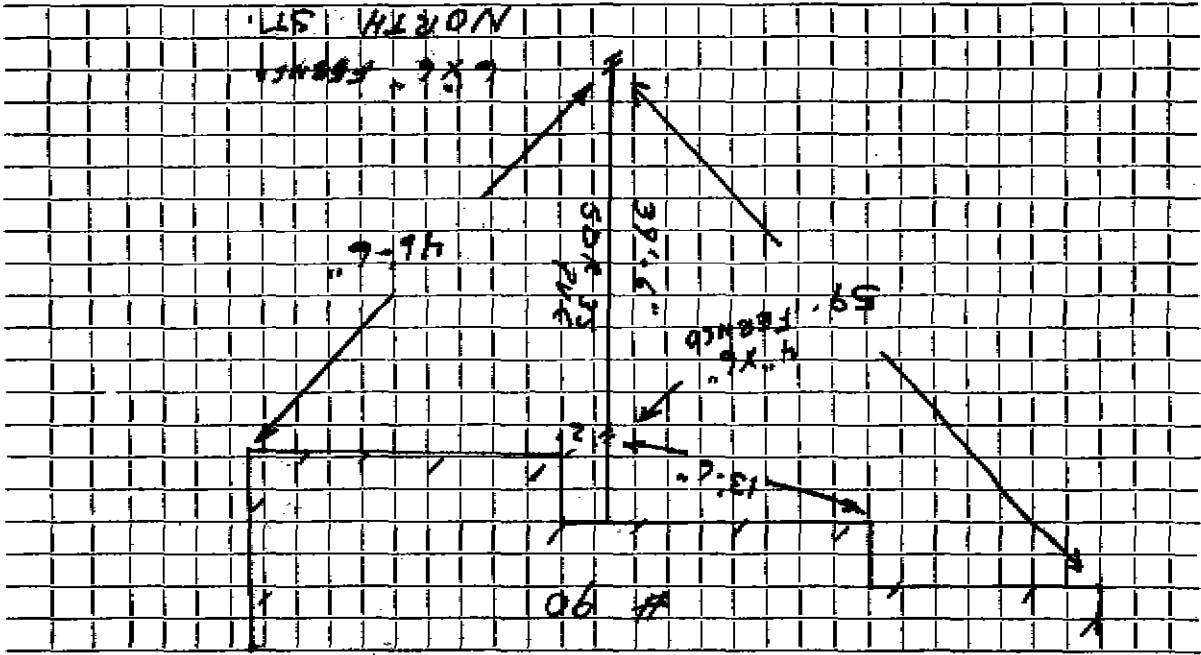

Work completed

Street

NORTH ST.

Connection made in

Remarks: