


DATE 6/19/95

TOWN OF LEXINGTON — BOARD OF PUBLIC WORKS
SEWER DIVISION

Sketch of Service Here

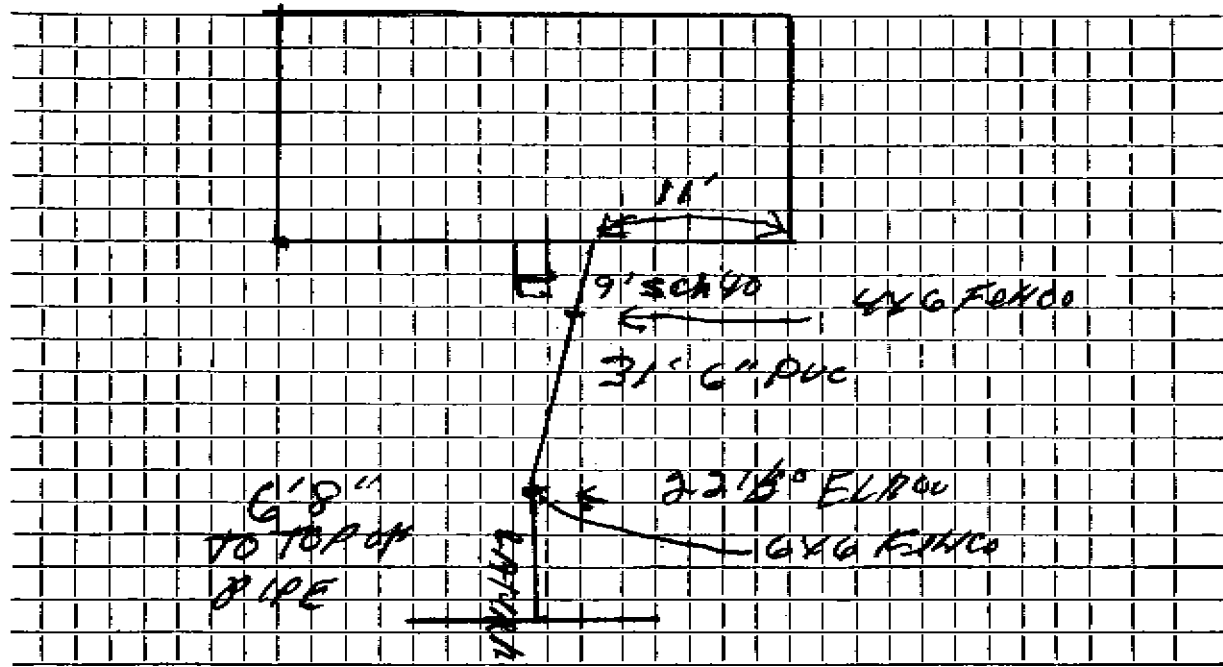

Connection made in NORTH Street.

Work completed 6/19/95

Remarks: BRUCE J. MEKEE