


DATE NOV 3 1997

TOWN OF LEXINGTON — BOARD OF PUBLIC WORKS

SEWER DIVISION

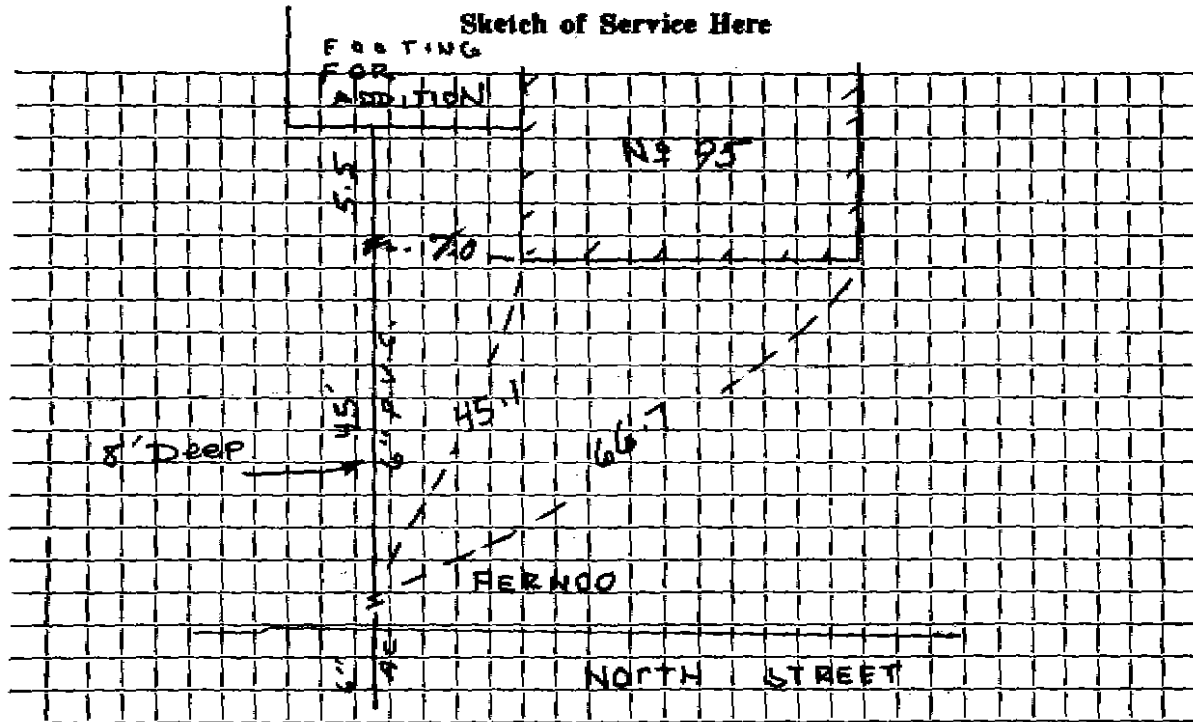

Connection made in NORTH Street. Work completed J. MCLAUGHLIN

Remarks:

FIELD BOOK 97-4 T.M.