


DATE 10/28/83

TOWN OF LEXINGTON — BOARD OF PUBLIC WORKS

SEWER DIVISION

Sketch of Service Here

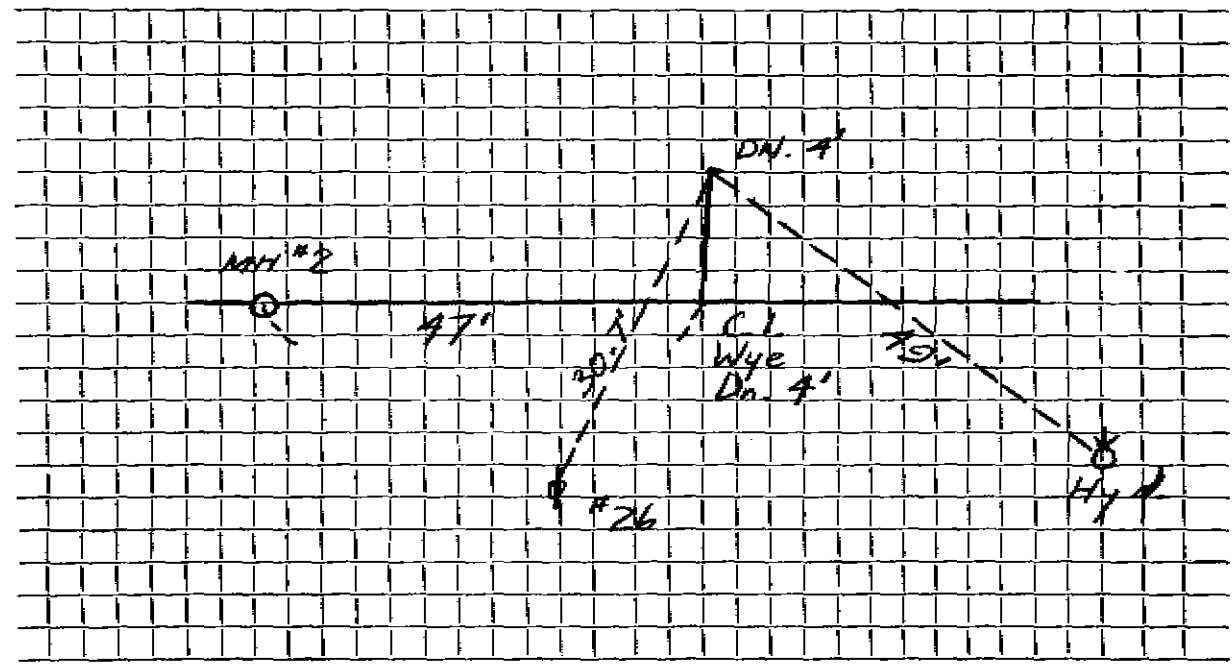

Connection made in NORTH Street. Work completed

Remarks:
.....
.....