




DATE 11-8-83

TOWN OF LEXINGTON — BOARD OF PUBLIC WORKS  
SEWER DIVISION

Sketch of Service Here

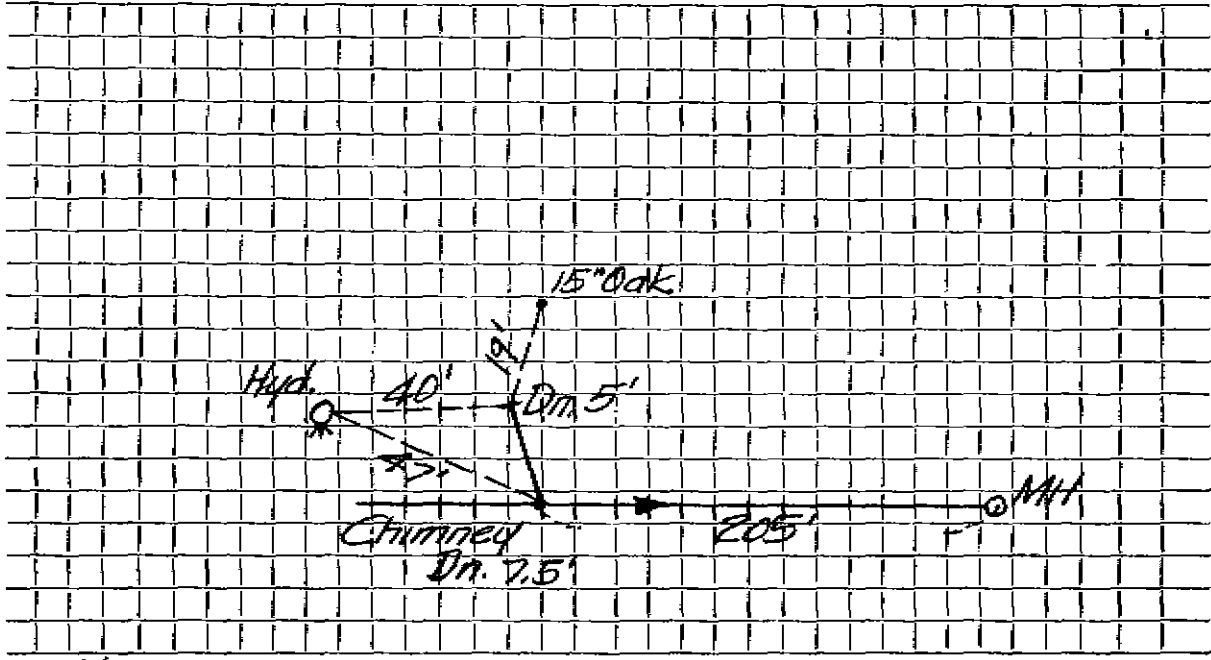

Connection made in North St. Street. Work completed .....

Remarks: .....  
.....  
.....