


DATE 9-12-90

TOWN OF LEXINGTON — BOARD OF PUBLIC WORKS

SEWER DIVISION

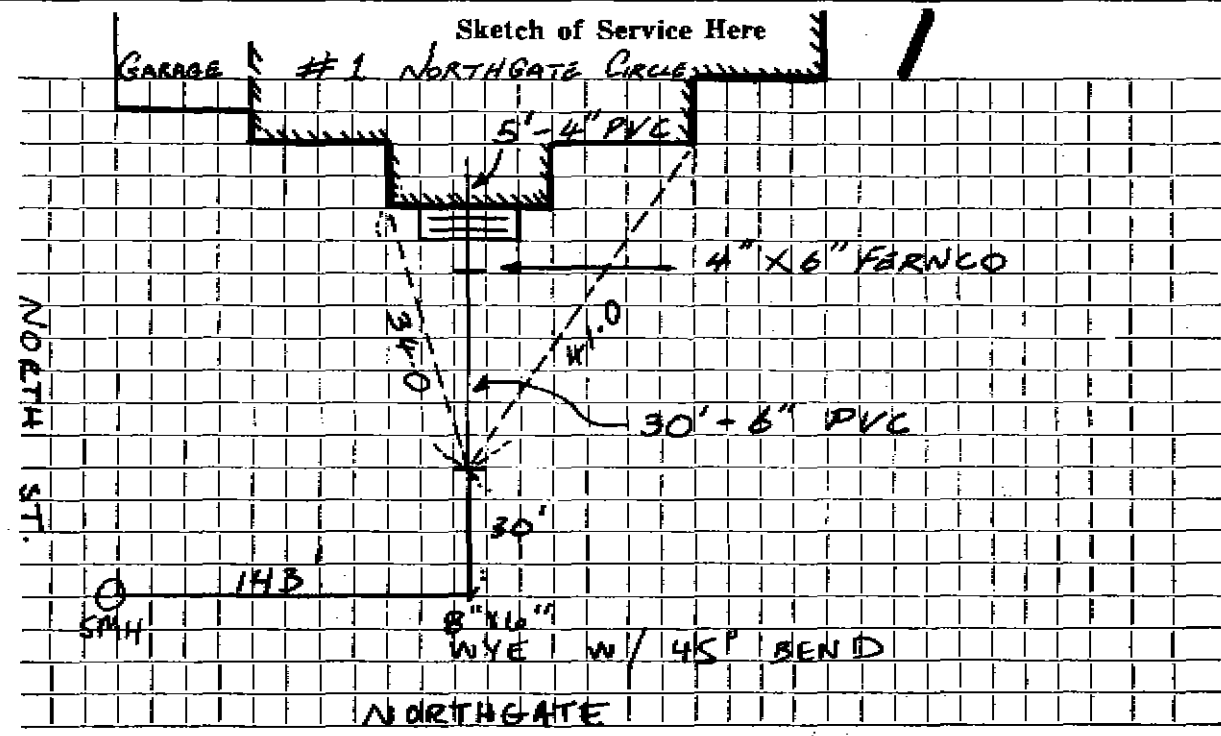

Connection made in NORTHGATE CIRCLE Street: Work completed

Remarks: INSPECTED 8-4-89 BY CRG INSTALLED BY J. McLAUGHAN