


DATE 7/27/92

TOWN OF LEXINGTON — BOARD OF PUBLIC WORKS
SEWER DIVISION

Sketch of Service Here
#2 NORTHGATE CIRCLE 2

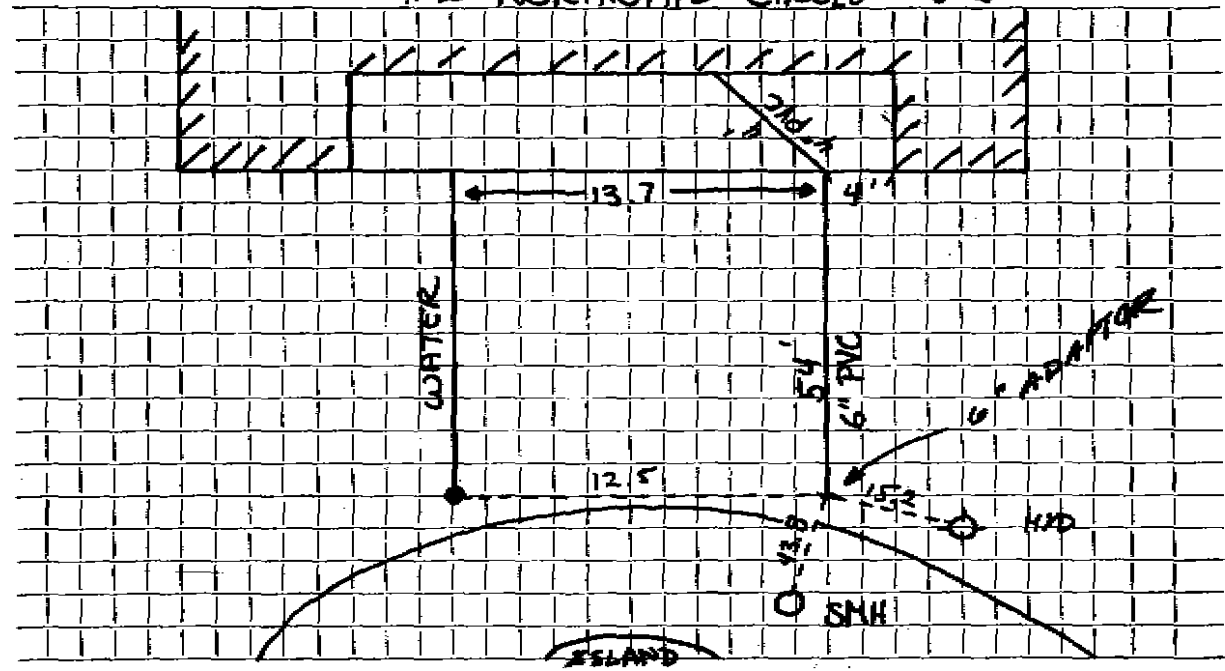

Connection made in NORTHGATE CIR. Street. Work completed

Remarks: INSTALLED BY: J. M'LAUGHLIN

INSPECTED BY: