

Name

Service No.

Address 10 NORTON RD

MCLAUGHLIN

Location

Kind of Pipe

Size

Size of Main

Repair ~~Renewal~~ New Service

Location

Date

Material

Amount

Total

Date

Amount

2/20/17

6" SDR

1/8" CLEAN OUT

4" PVC CAP

4' SDR BUNCH


1/8" TEE W/ U

6x6 FERNCO

DATE 2/2017

TOWN OF LEXINGTON — BOARD OF PUBLIC WORKS
SEWER DIVISION

Sketch of Service Here

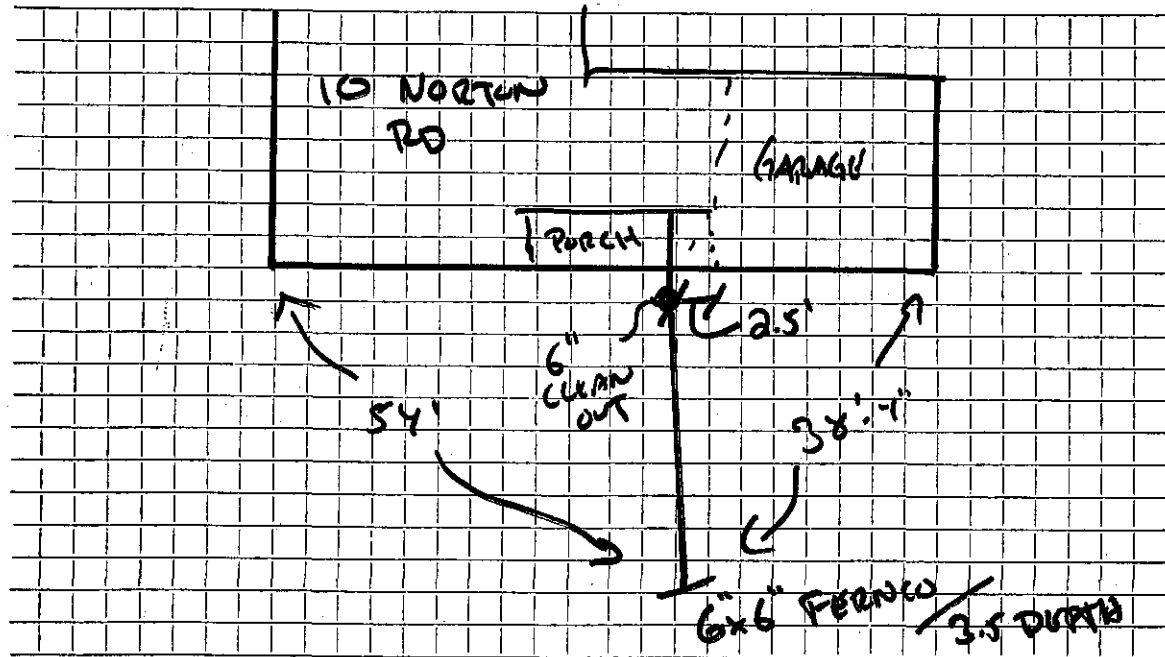

Connection made in NORTON Street. Work completed MCLAUGHLIN

Remarks:

.....

.....