

Name

Service No.

Address

11 Norton Rd

Location

Kind of Pipe

SDR 35 PVC

Size

6"

Size of Main

Repair

Renewal

New Service

Location

Date

Material

Amount

Total

Date

Amount

3/19/21

4" x 6" FernCo

6" tee wye

6" cleanout depth = 4'7"


6" SDR 35 PVC

6" FernCo Stub

DATE 3/19/2021

TOWN OF LEXINGTON — BOARD OF PUBLIC WORKS  
SEWER DIVISION

Sketch of Service Here

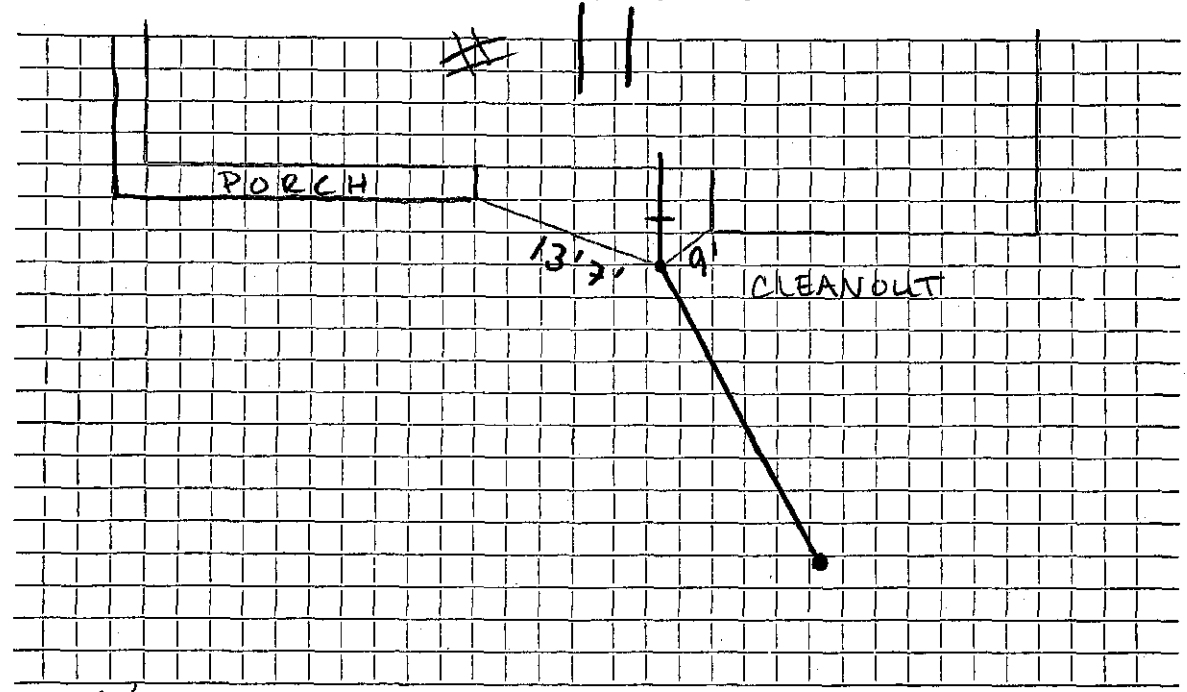

Connection made in Norton Street. Work completed .....

Remarks: .....  
.....  
.....