

Name **Paul Winter**

Service No.

Address **6 Norton Rd.**

6 Norton Rd

Location

Kind of Pipe

Size **6"**

Size of Main **8"**

Repair—Renewal—New Service

Lucente #2728

Location

Date		Material	Amount		Total		Date		Amount	
/10/75	50'	6" Transite Pipe								
	10'	4" Cast Iron Pipe								


DATE _____

TOWN OF LEXINGTON — BOARD OF PUBLIC WORKS

SEWER DIVISION

Sketch of Service Here

6

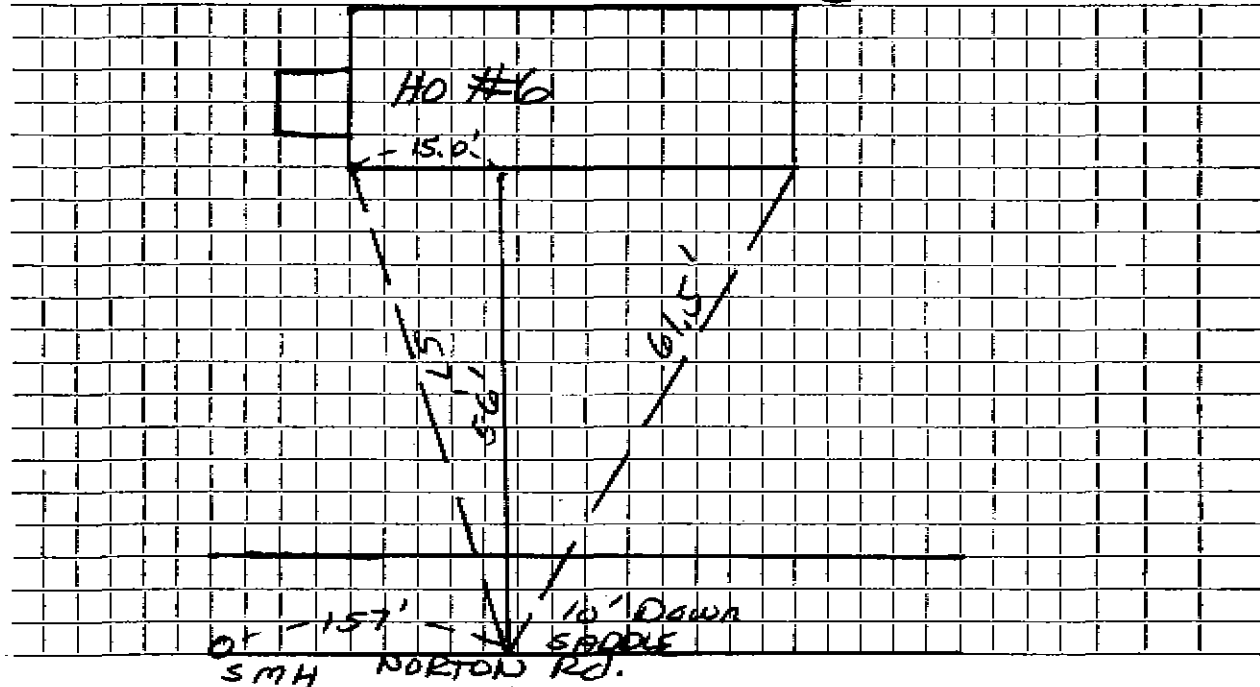

Connection made in Street. Work completed

Remarks:

.....
.....