


DATE _____

TOWN OF LEXINGTON — BOARD OF PUBLIC WORKS

SEWER DIVISION

Sketch of Service Here **7**

44' of Sewer Service
from Main to House
Installed 4/23/64

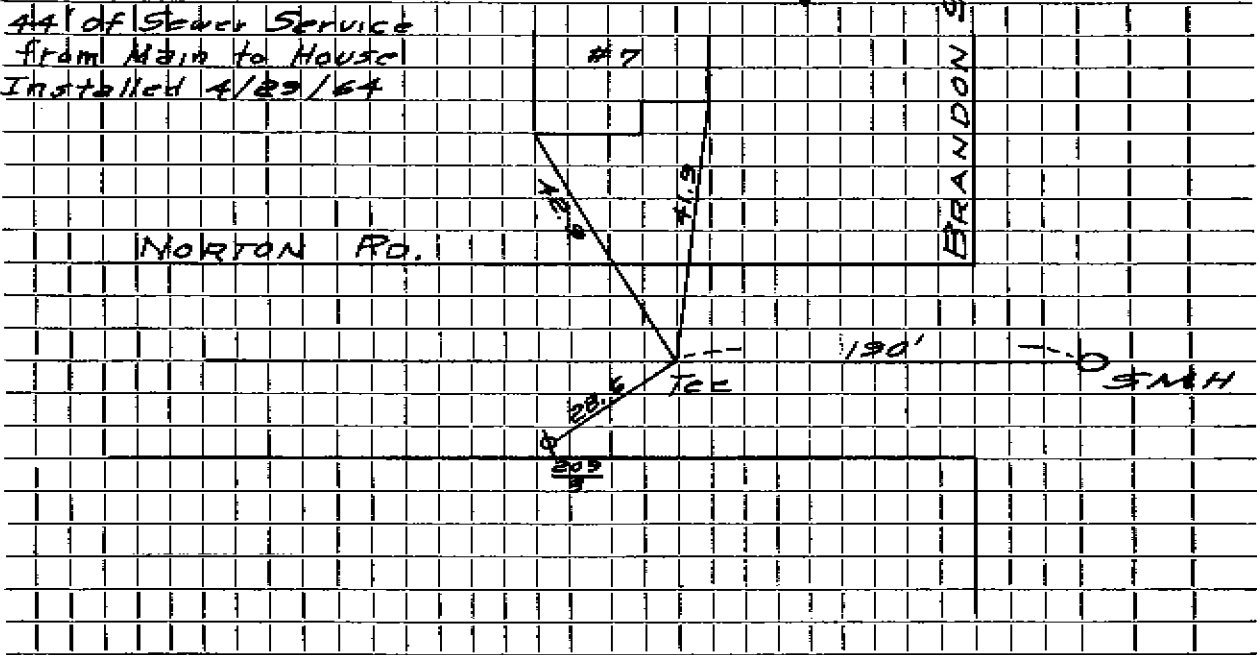

Connection made in Street. Work completed

Remarks:
.....
.....