

Name R. D. Hamilton Const. Co.

Service No.

Address # 9 Norton Rd.

DeFlice Bros. Permit #7 9 Norton Rd. Location

Kind of Pipe

Size 6"

Size of Main 8"

~~REPLACEMENT~~ **New Service**

Location

Date	Material	Amount	Total	Date	Amount
29-64	45' 6" Transite pipe				
2-16-69	3' 6" Transite				
	1 6" Adapter				


DATE \_\_\_\_\_

TOWN OF LEXINGTON — BOARD OF PUBLIC WORKS

SEWER DIVISION

Sketch of Service Here

9

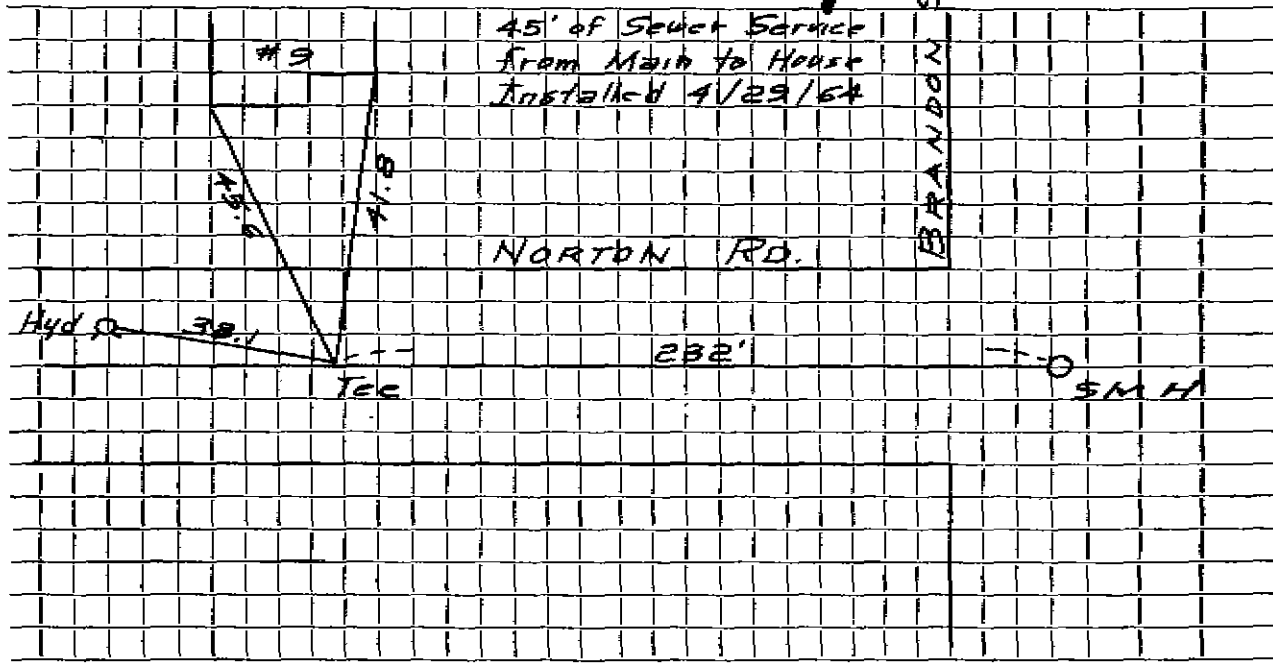

Connection made in ..... Street. Work completed .....

Remarks: .....  
.....  
.....