

Name Moore Realty Trust

Service No. 22

Address ~~225 Blake Rd.~~ ^{11 Nowers Rd.}

LOT 1 1 Nowers Rd. Location

Kind of Pipe

Size 6"

Size of Main

~~Repair~~ ~~Reconnect~~ New Service DeFlice Bros Permit #229

Location MAY 17 1965

Date	Material	Amount	Total	Date	Amount
1964-325	6" Transite pipe install by contractor @ 7.00 per ft.		227 50	3-26-65	227 50
12-65	48' 6" Transite pipe			1964	
				326' - 6" Transite	
				1 6" x 8" Wye	



TOWN OF LEXINGTON
OFFICE OF SELECTMEN

5-8-07

Date

To *Douglas Morgan / Cynthia Sicker*

Under Article 6 section 2 of the General By-Laws of the Town of Lexington, it is ordered that "The Selectmen shall determine and designate numbers for the buildings abutting upon or adjacent to such streets or portions of streets as they may deem best for public convenience. No person shall neglect or refuse to affix to any building owned by him, the street number designated for him by said board."

The owner of the building on

33 BLAKE RD.

Street

71/279

Lot No.

is hereby notified that
the proper number is

2 NOWERS RD.


BOARD OF SELECTMEN

By

Peter Karalakis

TOWN OF LEXINGTON — BOARD OF PUBLIC WORKS
SEWER DIVISION

Sketch of Service Here

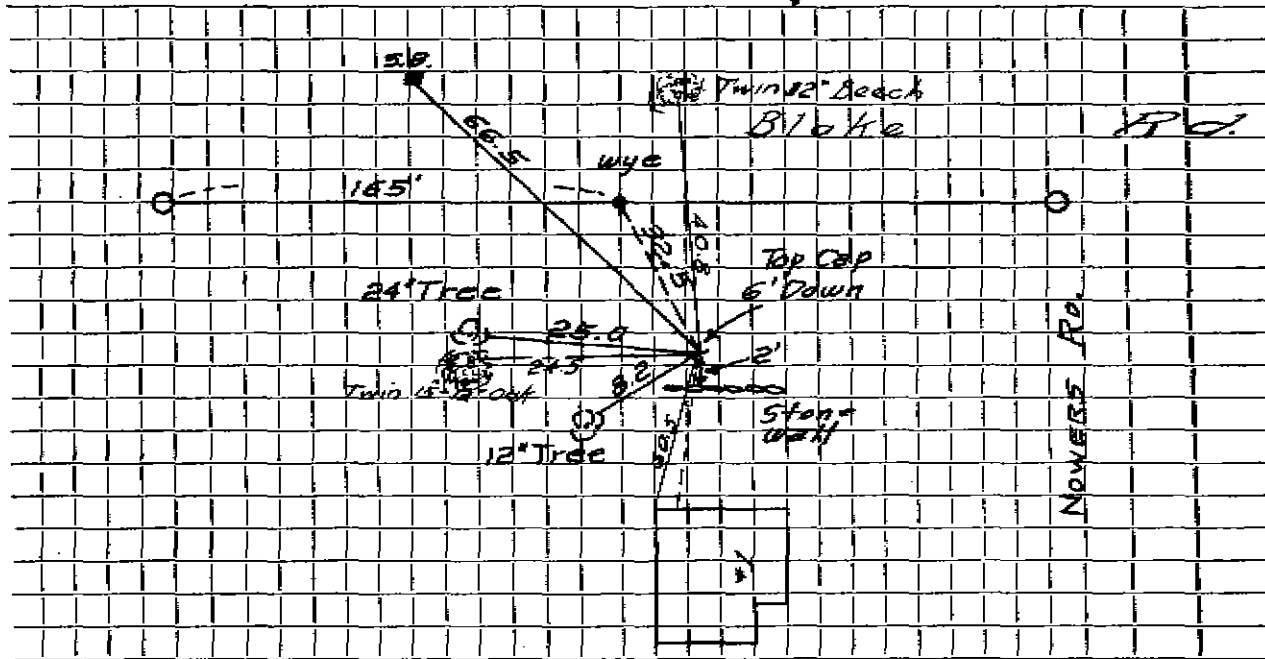

Connection made in Street. Work completed

Remarks:
.....
.....