

Name Sheldon CABF

Service No.

Address 3A KOWER Rd

PERMIT # 1466

Location OLD ADDRESS 32 BURLINGTON ST

Kind of Pipe PVC To RC

Size 6"

Size of Main 8"

Repair-Renewal-New Service


Location

Date	Material	Amount	Total	Date	Location	Amount
10-15 2000	INSIDE.			8-28	OUTSIDE	
	43'-6" PVC			62	8' 6" AC	
	5'-4" PVC				1-2 1/2 ELBOW	
	1-4X6" FERRO					
	1-6" RC TO 6" PVC FERRO					
	1-2 1/2 BEND.					

DATE 9-24-2001

TOWN OF LEXINGTON — BOARD OF PUBLIC WORKS
SEWER DIVISION

Sketch of Service Here

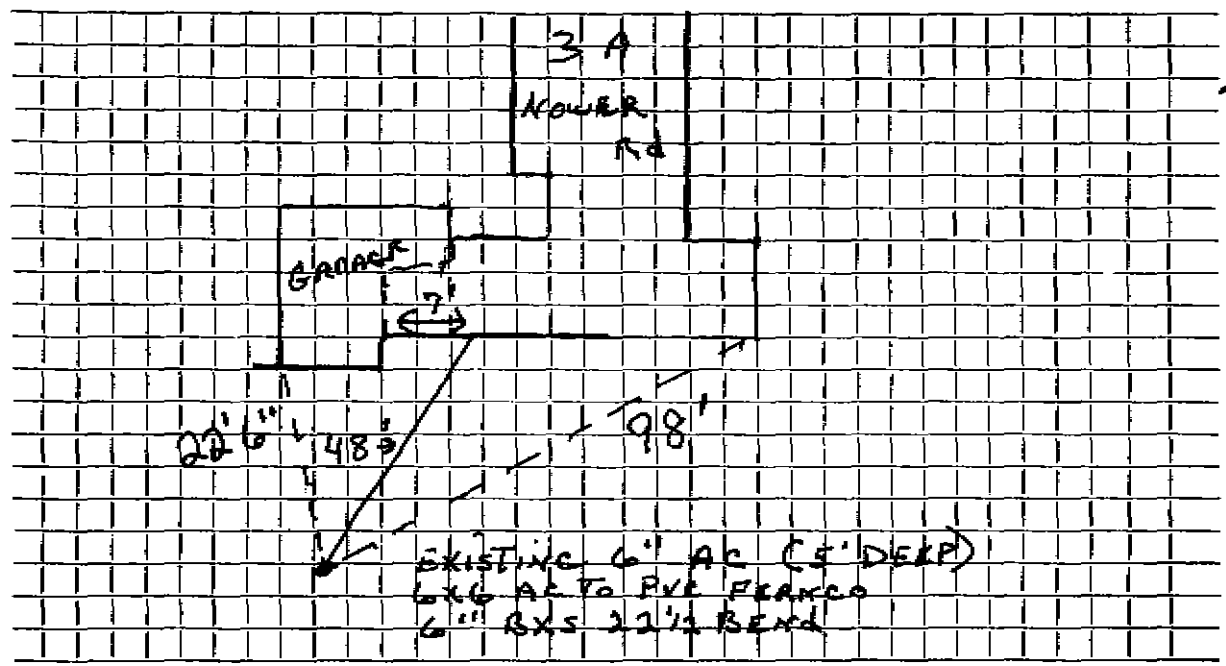

Connection made in .. BURLINGTON .. Street. Work completed

Remarks: .. INSTALLED .. BY .. J. M. SLAUGHLIN ..

..... FN. FILE LOOK UNDER BURLINGTON ST

..... IN METEER ROOM