

Name Helen F. Cody

Service No. 86

Address # 3 Nowers Rd.

3 Nowers Rd.

Location

Kind of Pipe

Size 6"

Size of Main

~~XXXXXXXXXX~~ New Service

Trebino permit # 2089

Location AUG 14 1972

Date	Material	Amount	Total	Date	Amount
264	<del>26' 6" Transite pipe install by contractor @7.00 per ft.</del>		182.00	6-13-72	182.00
				1964	
				26' 6" Transite	
1/16/72	45' 6" Transite			1 6" X 8" Wye	
	4' 4" Cast Iron				


DATE \_\_\_\_\_

TOWN OF LEXINGTON — BOARD OF PUBLIC WORKS

SEWER DIVISION

Sketch of Service Here

3

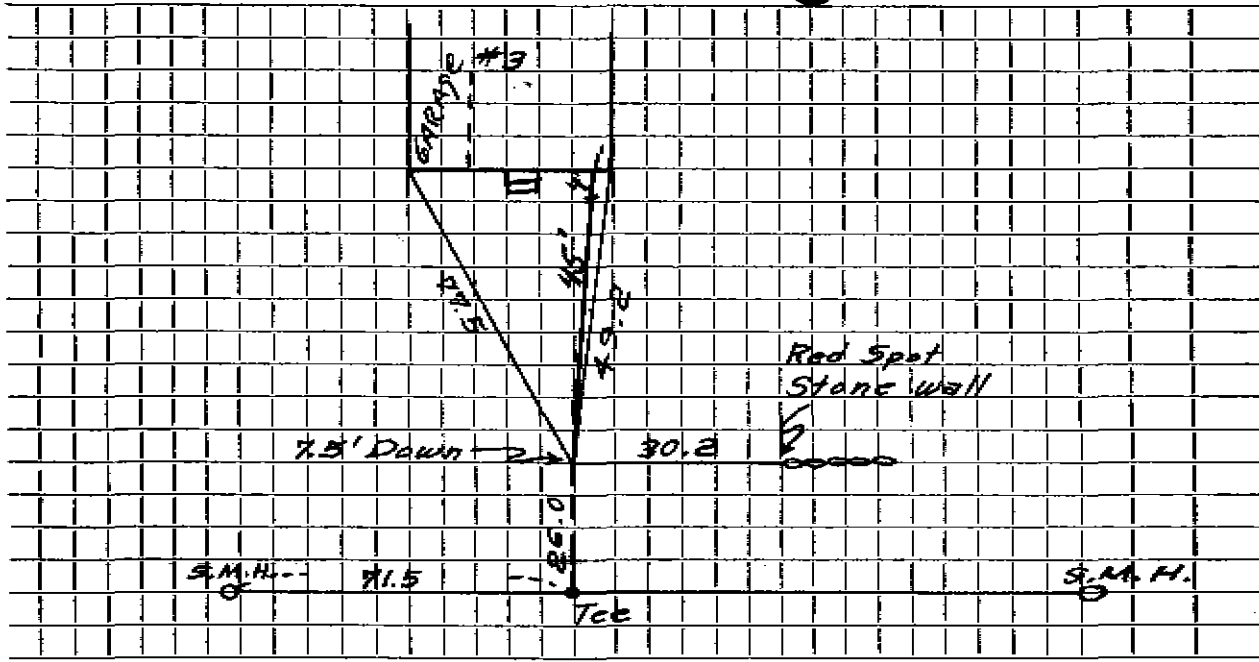

Connection made in ..... Street. Work completed .....

Remarks: .....  
.....  
.....