

Name

Service No.

Address

6 Nowfords

Location

Kind of Pipe

SERVICE NO. COMES, SIZE

Size of Main

Repair—Renewal—New Service

cut under addition

Location

Date

Material

Amount

Total

Date

Amount

4-20-04

10' - 4" PVC

4x6 PVC to PVC Franco


17' - 6" PVC

6x6 PVC to AC Franco

DATE _____

TOWN OF LEXINGTON — BOARD OF PUBLIC WORKS
SEWER DIVISION

Sketch of Service Here

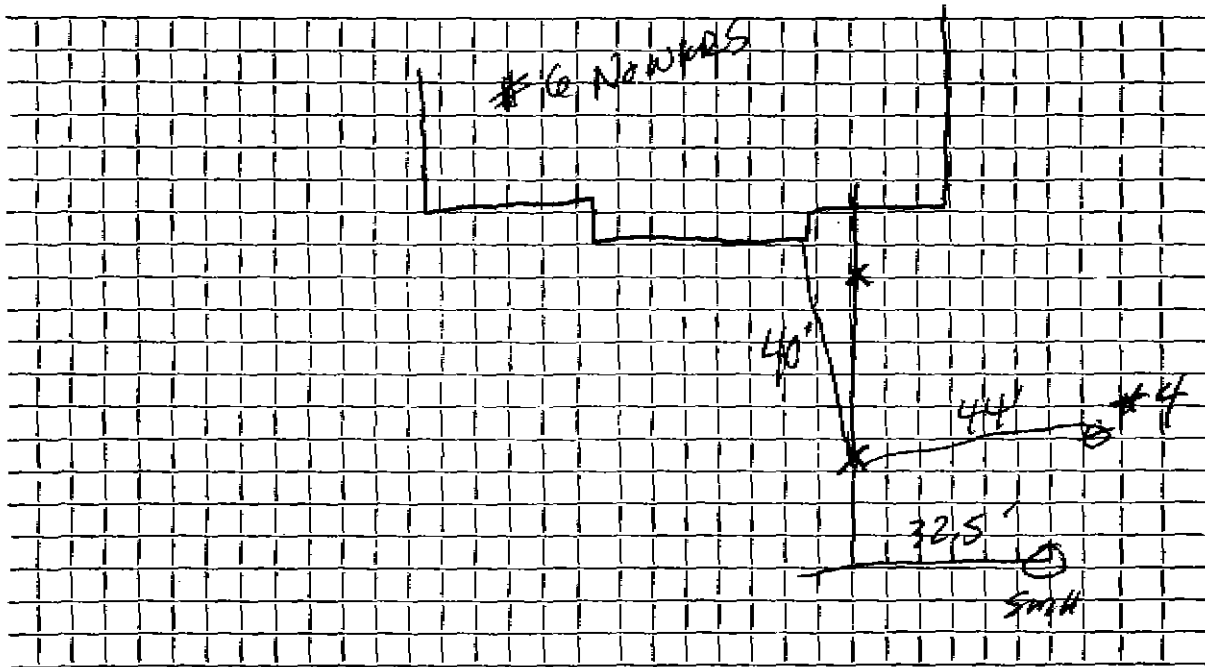

Connection made in Street. Work completed

Remarks:

.....

.....

