

Name Richard Townsend

Service No. 151

Address #7 Nowers Rd.

7 Nowers Rd.

Location

Kind of Pipe

Size 6"

Size of Main

~~REMOVED~~ New Service Russell A. Sibley - Permit #90

Location DEC 28 1964


Date	Material	Amount	Total	Date	Amount
1964	<del>16'</del> 6" Transite pipe install by contractor @ 7.00 per ft.		112 00	9-9-64	Deposit 46 00
				10-20-64	Paid 46 00
<del>1-22-64</del>	34' 6" Transite pipe			1964	112 00
					16' 6" Transite
					1 6" x 8" Wye

DATE \_\_\_\_\_

TOWN OF LEXINGTON — BOARD OF PUBLIC WORKS

SEWER DIVISION

Sketch of Service Here **7**

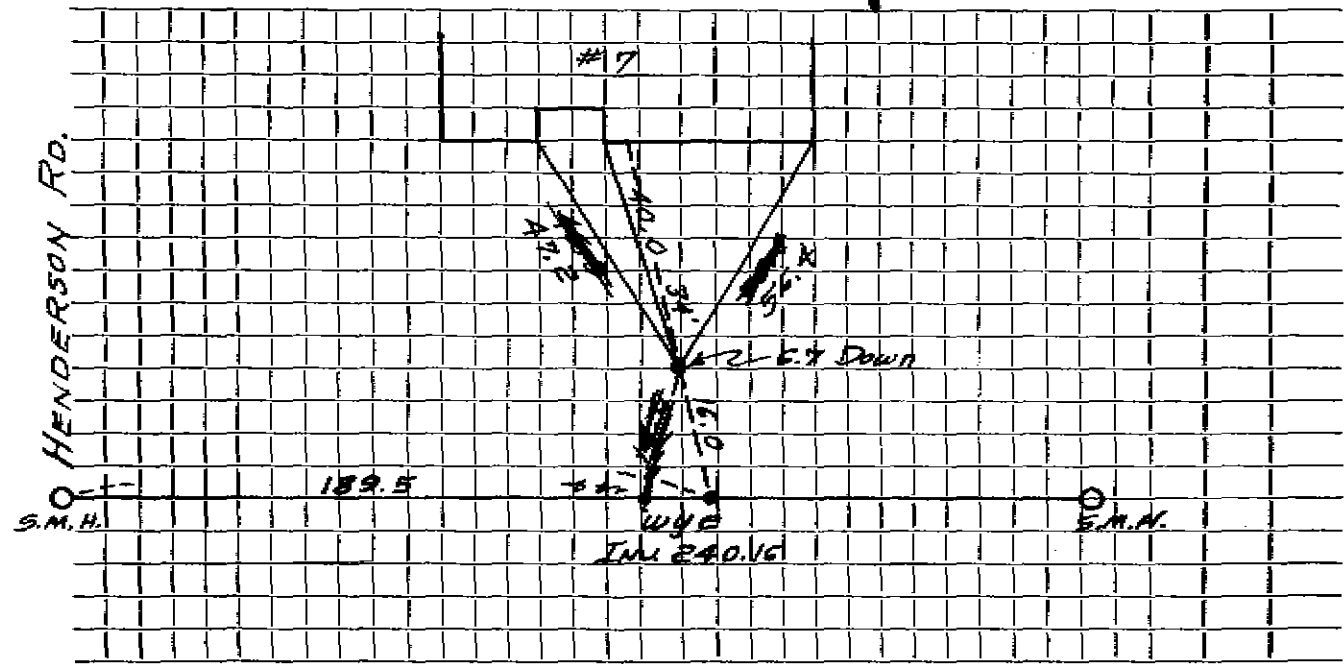

Connection made in ..... Street. Work completed .....

Remarks: .....  
.....  
.....