

Name

Service No.

Address # 8 NOWERS ROAD

8 Nowers Rd.

Location

Kind of Pipe

Size 6"

Size of Main

Repair—Renewal—New Service

Location

Date	Material	Amount	Total	Date	Location	Amount
4-6-83						
47'	6" P.V.C.					
10'	4" C.I. Pipe			1969		
2	6"-45° Elbow			16'	6" TRANSITE	
.1	6" X 6" P.V.C. to TRANSITE			1	6" X 8" WYE	
1	4" DONUT					


DATE \_\_\_\_\_

TOWN OF LEXINGTON — BOARD OF PUBLIC WORKS

SEWER DIVISION

Sketch of Service Here

8

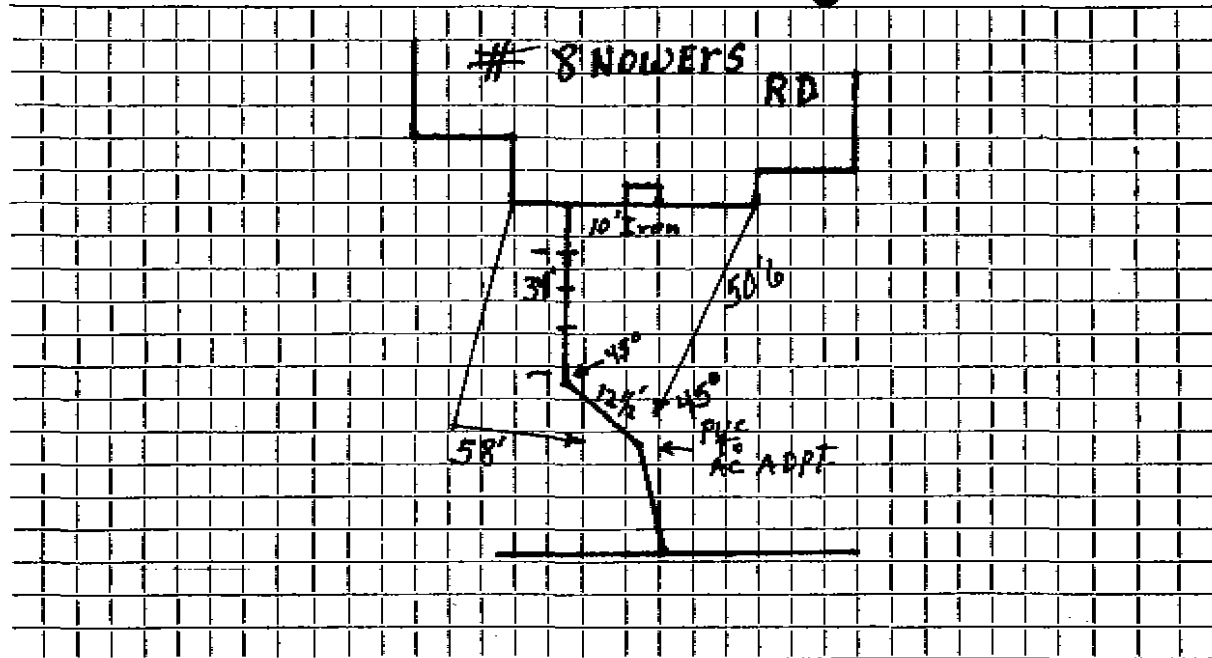

Connection made in ..... Street. Work completed .....

Remarks: 47'-6" PVC. IN - 16' Transite out