

1977

Name Nancy Lou Hayes

Service No. 33

Address #9 Nowers Rd.

9 Nowers Rd.

Location

JUN 20 1977

Kind of Pipe

Size 6"

Size of Main

~~REPAIR WORK~~ — New Service Valeri #3164


Location

Date	Material	Amount	Total	Date	Amount
1964	16' 6" Transite pipe install by contractor @ 7.00 per ft.		112.00	5/26/77	Deposit 112.00
6/77	40' 6" transite pipe			1969	
	5' 4" cast iron			16' 6" Transite	

DATE _____

TOWN OF LEXINGTON — BOARD OF PUBLIC WORKS
SEWER DIVISION

Sketch of Service Here **9**

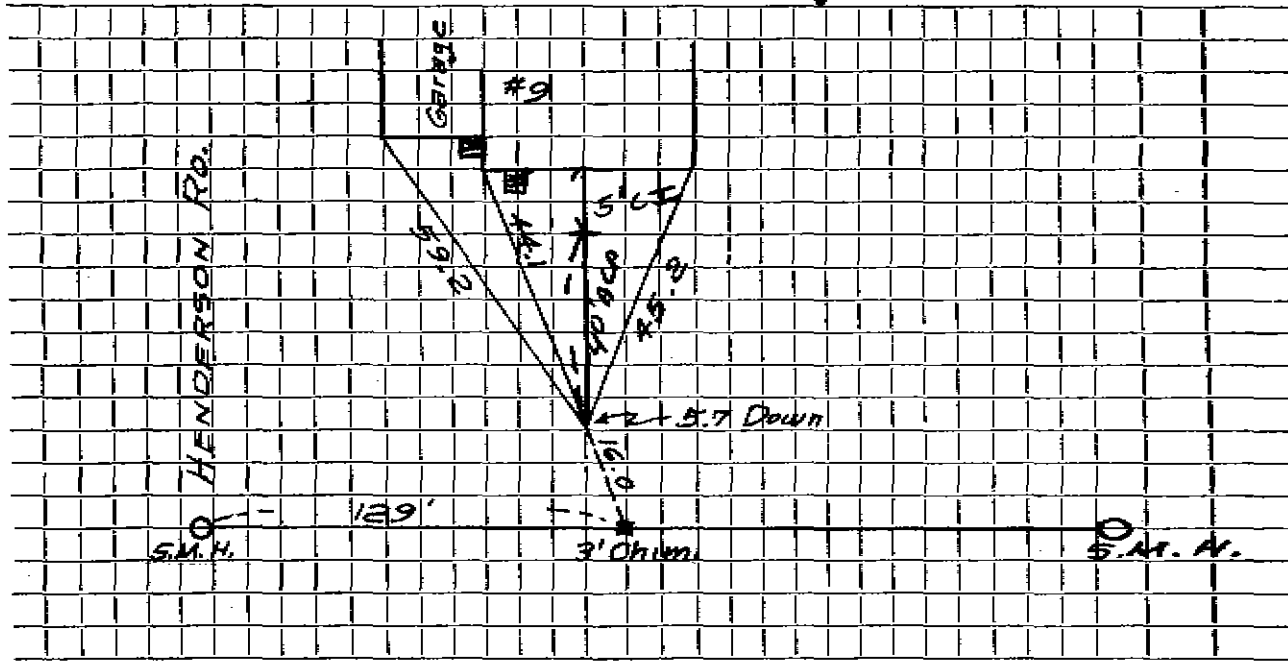

Connection made in Street. Work completed

Remarks:
.....
.....