

Name Pasquale Agostino

Service No.

Address 4 Oak Park Circle

lot #6 4 Oak Park Circle

Location

Kind of Pipe

Size 6"

Size of Main 8"

Repair—Renewal—New Service

Lucente #1452

Location

Date		Material	Amount	Total	Date		Amount
9-8-69	90'	6" Transite pipe					
	10'	4" Cast Iron pipe					

DATE _____


TOWN OF LEXINGTON — BOARD OF PUBLIC WORKS

SEWER DIVISION

Sketch of Service Here

Lot 6

4

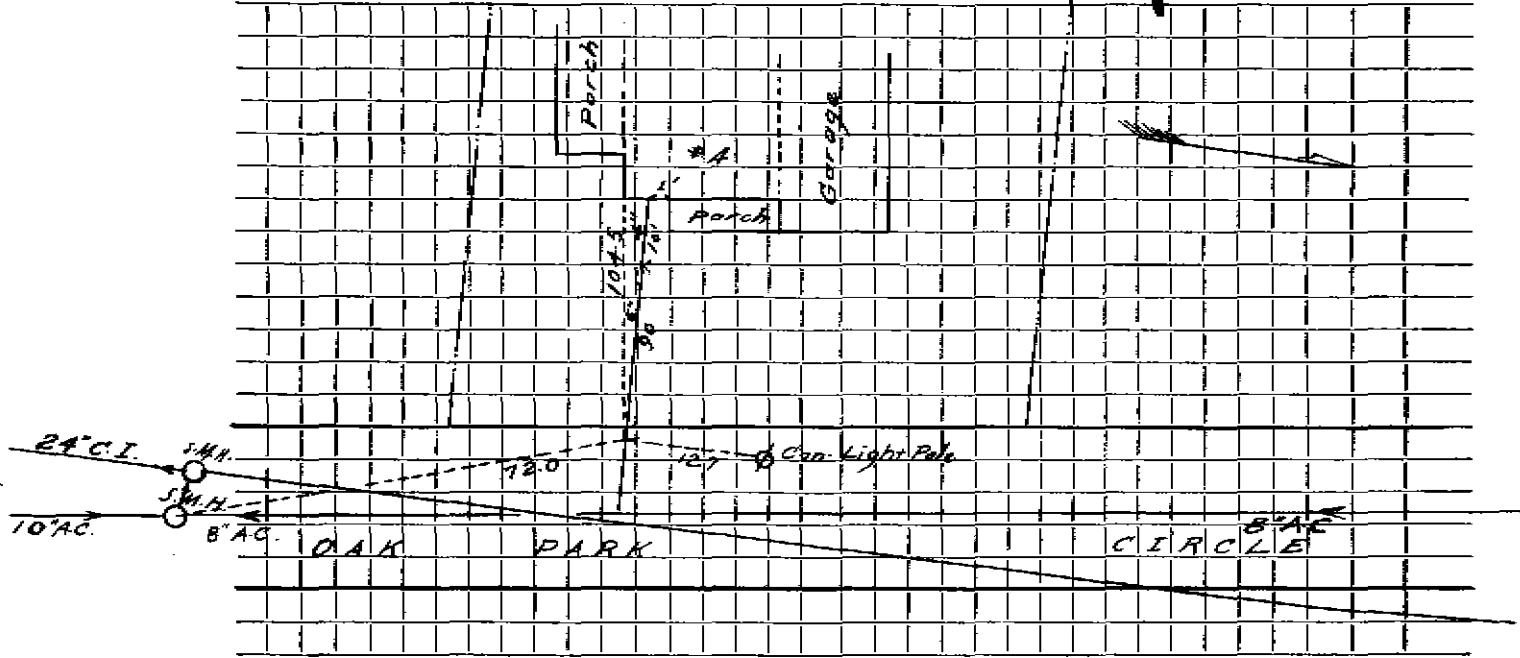

Connection made in Street. Work completed

Remarks:

.....

.....

.....