

Name Charles Chiklas

Service No.

Address 5 Oak Park Circle

5 Oak Park Circle

Location

Kind of Pipe

Size 6"

Size of Main 8"

Repair—Renewal—New Service Lucente #1715

Location

Date	Material	Amount	Total	Date	Amount
8-26-70	76' 6" Transite pipe				
	10' 4" Cast Iron pipe				


DATE _____

TOWN OF LEXINGTON — BOARD OF PUBLIC WORKS

SEWER DIVISION

Sketch of Service Here

5

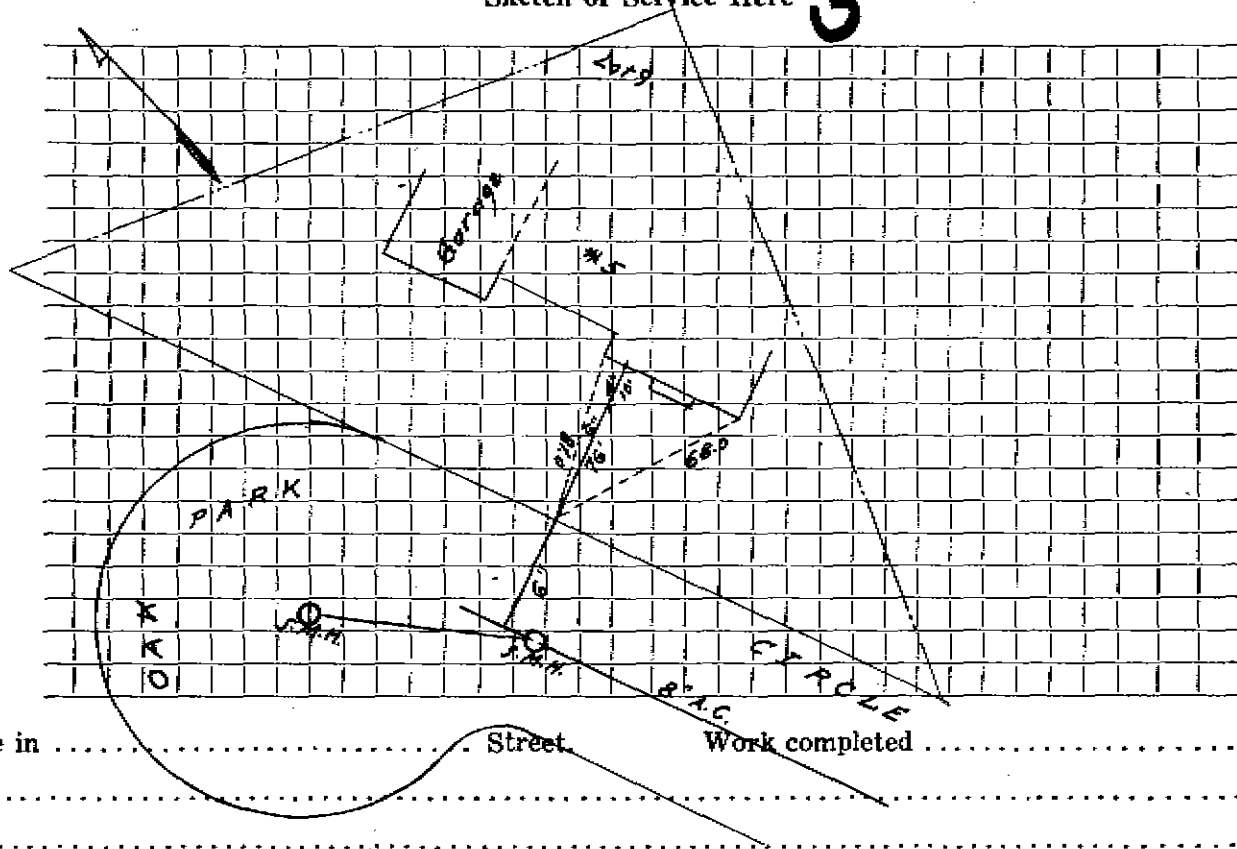

Connection made in Street. Work completed

Remarks:

.....

.....