

PERMIT
Service No. 1558

Name FAX WHITEFIELD
Address 7 OAKPARK CIR.

Location

Kind of Pipe RC Size 6 Size of Main

Repair—Renewal—New Service


Location

Date	Material	Amount	Total	Date	Location	Amount
7-12 2000	14' SIDE				OUTSIDE	
	32' 6" RC				6" RC	
	4" BACKFLOW +					
	GATE VALVE					
	1 MAN HOLE WITH					
	CASTING					

DATE 14-9-2001

TOWN OF LEXINGTON — BOARD OF PUBLIC WORKS
SEWER DIVISION

Sketch of Service Here

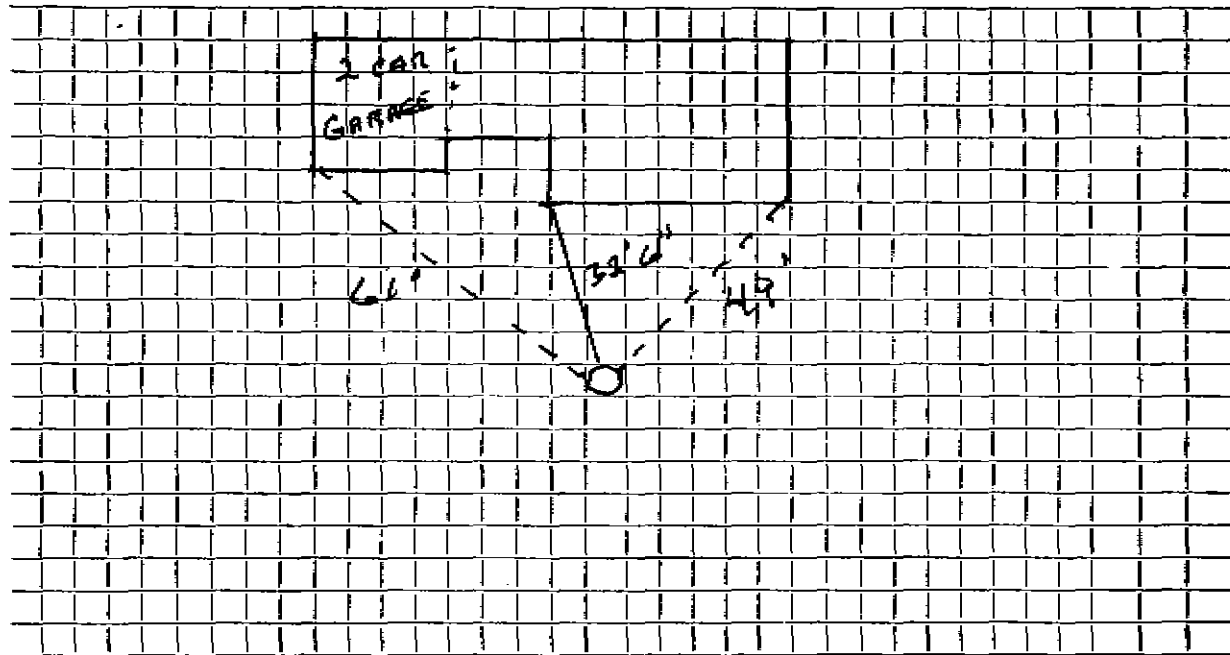

Connection made in PARK PARK CIR Street. Work completed

Remarks: INSTALLED BY J. Mc LAUGHLIN