

Address **18 Oak Street**

18 OAK ST.

Location **Lexington, Mass.**

Kind of Pipe **Com 6-1-51**

Size **6"**

Size of Main **8"**

~~Repair~~ **New Service**

Location

Date	Material	Amount	Total	Date	Amount
9-6-51	Labor	44 46	44 46	9-6-51	Deposited 125 10
	10% Overhead		4 45	10-1-51	Refunded 1 94
	62' - 6" 8 Hr Pipe @.342		21 20		Credited for M.C. #214 3 97
	1-6" Elbow		1 88		119 09
	Joint Compound		3 60		
	6 Hr. Littlefield Shovel		42 00		
	2 Hr. Trucking		1 50		
			119 09		
	Labor				

TOWN OF LEXINGTON—DEPT. OF PUBLIC WORKS
SEWER DIVISION

DATE

NO.


The undersigned applies for the construction of a particular sewer connecting No.
Street and hereby agrees to comply with the Rules and Regulations governing the construction and use of Particular
Sewers, as now or at any future time established by the Board of Selectmen.

Am't of estimate \$.....

Am't Paid \$.....

..... Owner

Sketch of Service Here

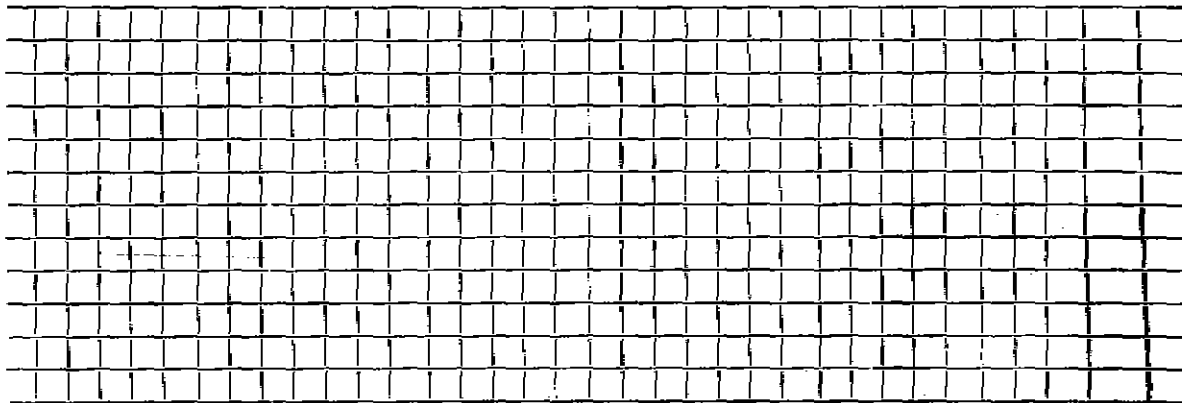

Connection made in Street.

Work completed 19..

Remarks: