

Name **Richard J. Belliveau**

Service No. **48**

Address **24 Oak Street**

Lexington 24 Oak ST. Location

Kind of Pipe **COM. 6-16-52**

Size **6"**

Size of Main **8"**

~~Sanitary Sewer~~ **New Service**

Location

Date	Material	Amount	Total	Date	Amount
5/28/52	Labor	74 05	74 05	4-21-52	150 00
	10% overhead		7 40	6-16-52	(8 27)
	62' - 6" sewer pipe @ .342		21 20		141 23
	1 - 6" 1/8 bend		1 36		
	joint compound		3 72		
	4 hrs. town shovel @ 5.00		20 00		
	2 hrs. trucking		1 50		
	patching 12 x 3		12 00		
			141 23		
	Labor				

TOWN OF LEXINGTON—DEPT. OF PUBLIC WORKS
SEWER DIVISION

DATE

NO.


The undersigned applies for the construction of a particular sewer connecting No.
Street and hereby agrees to comply with the Rules and Regulations governing the construction and use of Particular
Sewers, as now or at any future time established by the Board of Selectmen.

Am't of estimate \$.....

Am't Paid \$.....

..... Owner

Sketch of Service Here

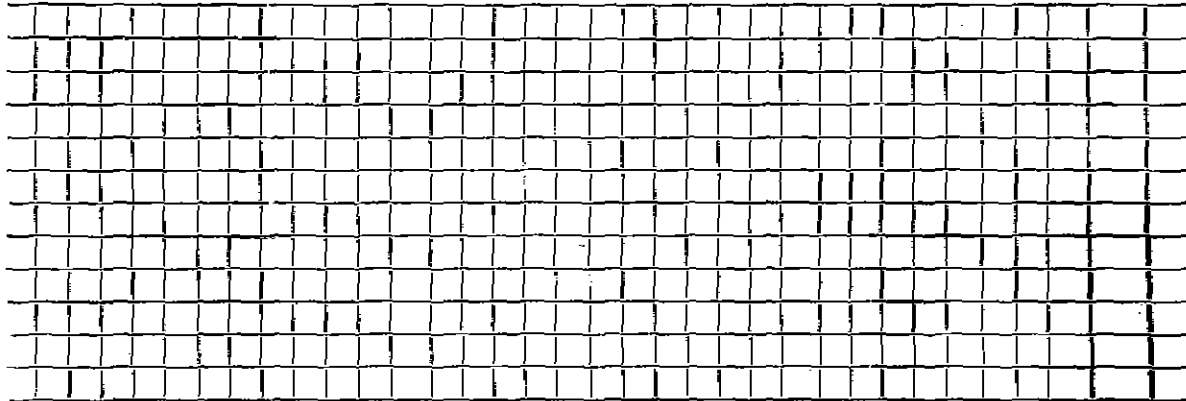

Connection made in Street.

Work completed 19..

Remarks: