


DATE _____

TOWN OF LEXINGTON — BOARD OF PUBLIC WORKS

SEWER DIVISION

Sketch of Service Here **33**

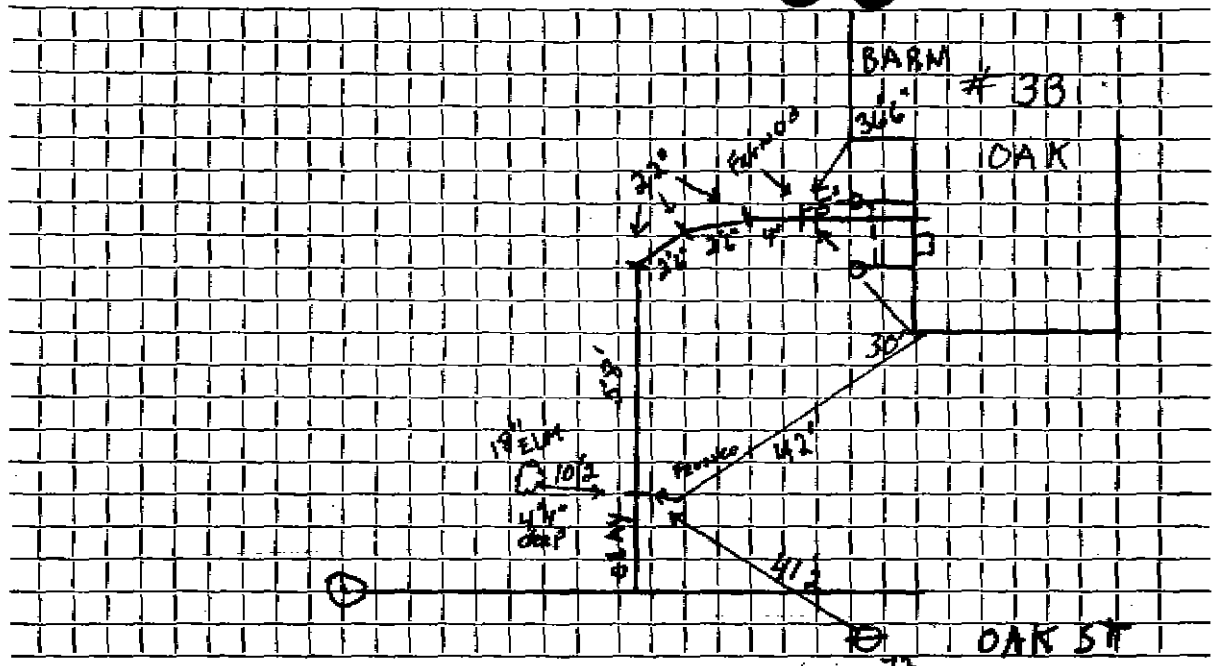

Connection made in Street. Work completed

Remarks: 7-2-87 - Clay in ST small roots coming in at Elbow