

Name **Gustav Larsen**

Service No. **47**

Address **40 Oak Street**

Lexington 40 Oak ST. Location **40 Oak Street**

Kind of Pipe

Size **6"**

Size of Main **8"**

~~Repair~~ ~~Renewal~~ **New Service**

Com. 11-6-50

Location

Date	Material	Amount		Total	Date	Amount
pt. 11 '50	Labor	30	43		<i>July 17 '50</i>	<i>Definited</i> 125 00
	10% Overhead	3	04	33 47	<i>Nov. 16 '50</i>	<i>Defunded</i> 20 67
	54' - 6" Sewer Pipe @ 28¢			15 12		104 33
	Joint Compound			3 24		
	5 hrs. Brox Shovel			45 00		
	2 hrs. Allis Chalmers			6 00		
	2 hrs. Trucking			1 50		
				104 33		
	Labor					

TOWN OF LEXINGTON—DEPT. OF PUBLIC WORKS
SEWER DIVISION

DATE

NO.


The undersigned applies for the construction of a particular sewer connecting No.
Street and hereby agrees to comply with the Rules and Regulations governing the construction **and** use of Particular
Sewers, as now or at any future time established by the Board of Selectmen.

Am't of estimate \$.....

Am't Paid \$.....

..... Owner

Sketch of Service Here

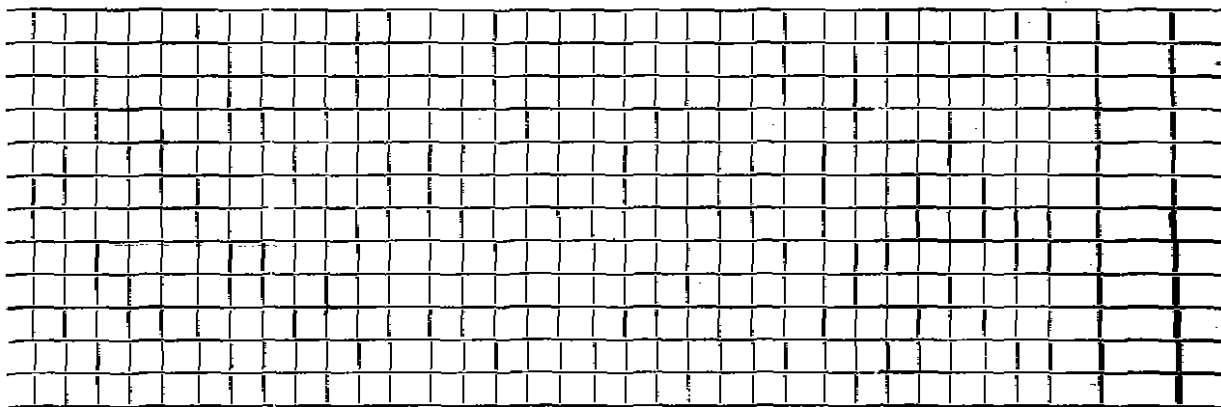

Connection made in Street.

Work completed 19..

Remarks: