

Name **Gustave Larson**Service No. **79**Address **54 Oak Street**Location **Lexington, Mass. 54 Oak St.** Location **54 Oak Street**

Kind of Pipe

Size **6"**Size of Main **8"**~~REPAIR~~ **New Service**Com. **11-14-49**

Location

Date		Material	Amount	Total	Date	Amount
t. 15,	'49	Labor	22 35	22 35	Oct. 15, 49	100 00
		10% Overhead		2 24	Nov. 17, 49	9 81
		68' - 6" Sewer Pipe @.265		18 02		<u>90 19</u>
		Joint Compound		4 08		
		Littlefield Shovel 6 hrs. @7.00		42 00		
		Trucking 2 hrs. @.75		1 50		
				90 19		
		<b>Labor</b>				

**TOWN OF LEXINGTON—DEPT. OF PUBLIC WORKS  
SEWER DIVISION**

DATE .....

NO. ....


The undersigned applies for the construction of a particular sewer connecting No. ....  
Street and hereby agrees to comply with the Rules and Regulations governing the construction **and use of Particular**  
Sewers, as now or at any future time established by the Board of Selectmen.

Am't of estimate \$. ....

Am't Paid \$. ....

..... Owner

**Sketch of Service Here**

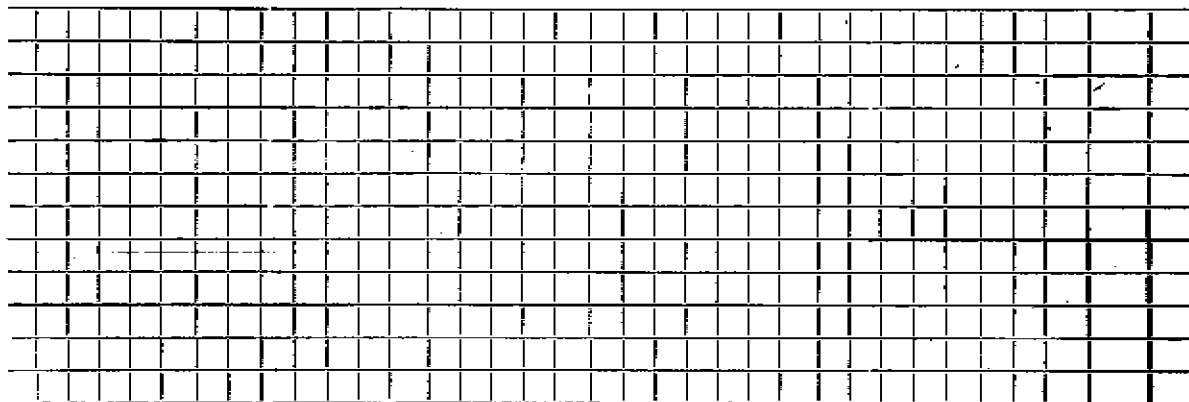

Connection made in ..... Street.

Work completed ..... 19..

Remarks: