

Name Chester BearsService No. 40 953Address 62 Oak Street62 OAK ST.Location 62 Oak Street

Kind of Pipe

Size 6"Size of Main 8"~~Repair~~ ~~Replacement~~ New Service

Location

Date	Material	Amount	Total	Date	Amount	
June 22 '45	Labor	55 71		June 19 '45	150 00	
23 '45	"	40 91		July 27 '45	26 01	
24 '45	"	31 92	128 54		176 01	
	10% Overhead		12 85			
	62' - 6" Sewer Pipe @.22		13 64		Material used - not charged	
	10' - 4" Iron Pipe @.50		5 00		1 1/2" - 15" Concrete Pipe	75
	1 - 1/8-6" Bend		67		1 Pit meter Cover	4 15
	Joint Compound		3 84		18 Brick	25
	12 Sticks Dynamite		1 20		1/2 Bag Cement	40
	16 Exploders		1 60		Compressor 16 hrs. @1.75	28 00
	Patching 13 x 3		8 67		Trucking 5 hrs. @.75	3 75
	Labor		176 01			37 30
					Bill sent 7-9-45	

TOWN OF LEXINGTON—DEPT. OF PUBLIC WORKS

SEWER DIVISION

DATE

NO.

The undersigned applies for the construction of a particular sewer connecting No.
Street and hereby agrees to comply with the Rules and Regulations governing the construction and use of Particular
Sewers, as now or at any future time established by the Board of Selectmen.


Am't of estimate \$.....

Am't Paid \$.....

..... Owner

Sketch of Service Here

62

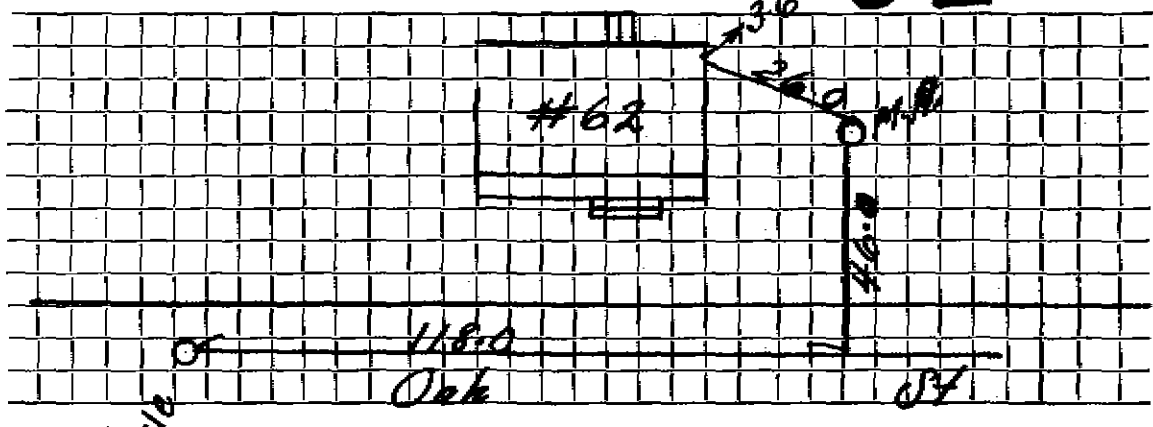

Connection made in

Street.

Work completed

19..

Remarks:

Carville Ave