

Name George Stygles

Service No. 142 (1956)

Address 65 Oak Street

65 OAK ST.

Location

Comm. 2/25/56

Kind of Pipe

Size 6"

Size of Main 8"

Depth: ~~Excavated~~ - New Service

Location

Date	Material	Amount	Total	Date	Amount
11/2/56	Labor	68 25		9-27-56	Deposit \$1,000 00
	10% overhead	6 83	75 08	2/25/57	Refund 1 75
	16' - 6" Sewer pipe @ .435		6 96		\$ 98 25
	Joint compound		96		
	1 hr. Trucking		75		
	8x3 Patching		8 00		
	1 hr. Town shovel		6 50		
			98 25		
	Labor				

# TOWN OF LEXINGTON—DEPT. OF PUBLIC WORKS

## SEWER DIVISION

DATE .....

NO. ....


The undersigned applies for the construction of a particular sewer connecting No. ....  
Street and hereby agrees to comply with the Rules and Regulations governing the construction and use of Particular  
Sewers, as now or at any future time established by the Board of Selectmen.

Am't of estimate \$.....

Am't Paid \$.....

..... Owner

### Sketch of Service Here

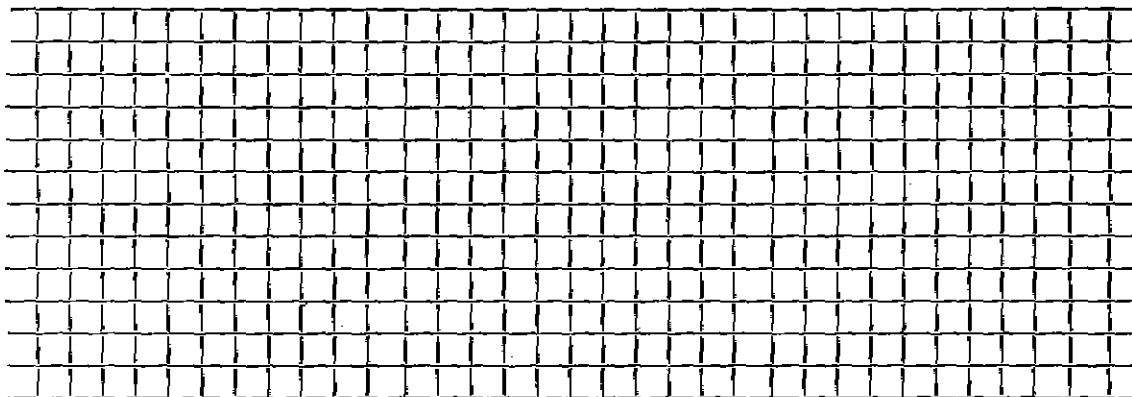

Connection made in ..... Street.

Work completed ..... 19..

Remarks: