

Address 66 Oak Street, Lexington, Mass.

66 OAK ST.

Location

Kind of Pipe

Size 6"

Size of Main 8"

Work - Sewer - New Service

Location

Date 1943	Material	Amount	Total	Date	Amount
July 12,	50 hrs. @ 65¢	32 50		June 1, 1943 Deposited	80 00
Con / re / as	11 " @ 70¢	7 70		Aug 20, 1943 Paid	5 74
	20 " @ 80¢	16 00	56 20	and bill 5 74	85 94
	10% Overhead		5 62		
	32' 6" Sewer Pipe @ 16¢		5 12		
	Joint compound		1 92		
	2 hrs. compressor @ 2.25		4 50		
	2 " trucking @ 75¢		1 50		
	Trench repairs		10 88		
			85 74	Bill for 5 74 sent 1/17/43	
	Labor				

Hadley Press, Inc., Lexington

TOWN OF LEXINGTON—BOARD OF PUBLIC WORKS

SEWER DIVISION

DATE June 1, 1943

NO. _____

The undersigned applies for the construction of a particular sewer connecting No. 66 Oak St Street and hereby agrees to comply with the Rules and Regulations governing the construction and use of Particular Sewers, as now or at any future time established by the Board of Selectmen.


Am't. of Estimate \$ 80⁰⁰

Am't. Paid \$ _____

Chester H. Monte. Owner

Sketch of Service Here

66

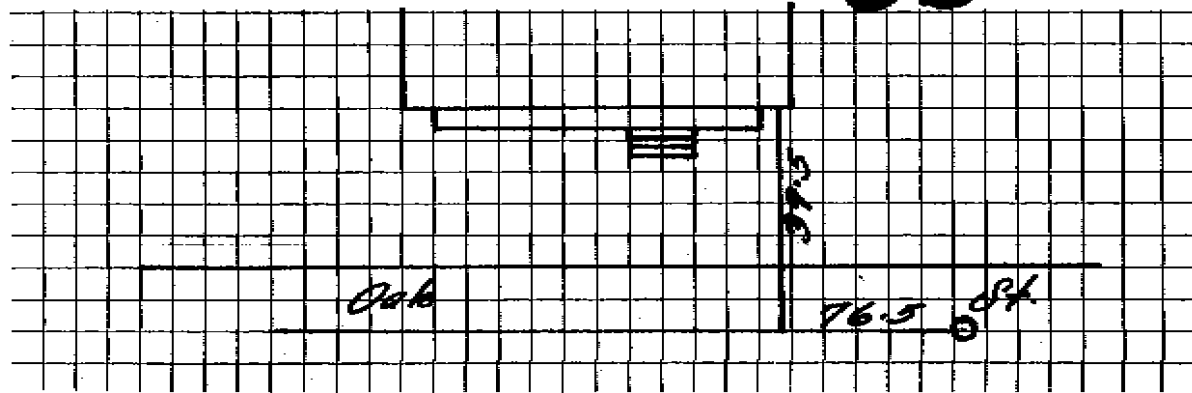

Connection made in _____ Street.

Work completed _____ 19

Remarks: