

Name ~~Donald S. Wilson~~ Mary Ellen Mitropoulos

Service No. 72

Address 69 Oak Street

69 Oak St.

Location

Kind of Pipe

Arlax #0018

Size 6"

Size of Main 8"

~~Repair~~ ~~Renewal~~ New Service

COM. 7-13-53

Location

Date	Material	Amount	Total	Date	Amount
6/10/53	Labor	35 42		4-22-53	Deposited 135 00
	10% overhead	3 54	38 96	7-13-53	Refunded 14 40
	28' - 6" sewer pipe @ .342		9 58		110 60
	1 - 6" elbow		1 38		
	joint compound		1 68		
	6 hrs. Littlefield shovel @ 7.50		45 00		
	2 hrs. trucking		1 50		
	patching 12 x 3		12 00		
			110 60		
	<b>Renewal</b>				
10/19/89	10' 4" CI				
	4" 22° CI Bend				
	6' labor 4" PVC				

TOWN OF LEXINGTON—DEPT. OF PUBLIC WORKS  
SEWER DIVISION

DATE.....

NO. ....

The undersigned applies for the construction of a particular sewer connecting No.....  
Street and hereby agrees to comply with the Rules and Regulations governing the construction and use of Particular  
Sewers, as now or at any future time established by the Board of Selectmen.


Am't of estimate \$.....

Am't Paid \$.....

..... Owner

Sketch of Service Here

69

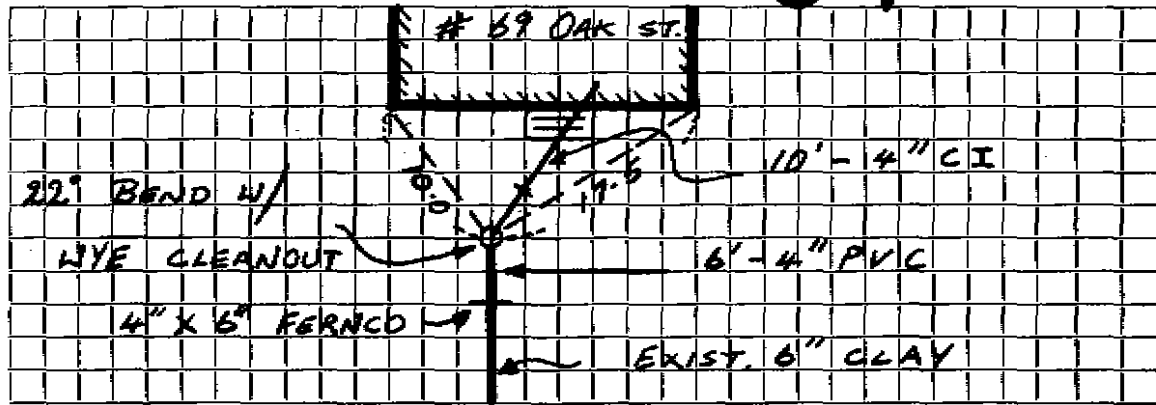

Connection made in..... OAK..... Street.

Work completed..... 19..

Remarks: