


DATE 6/8/23

TOWN OF LEXINGTON — BOARD OF PUBLIC WORKS
SEWER DIVISION

Sketch of Service Here

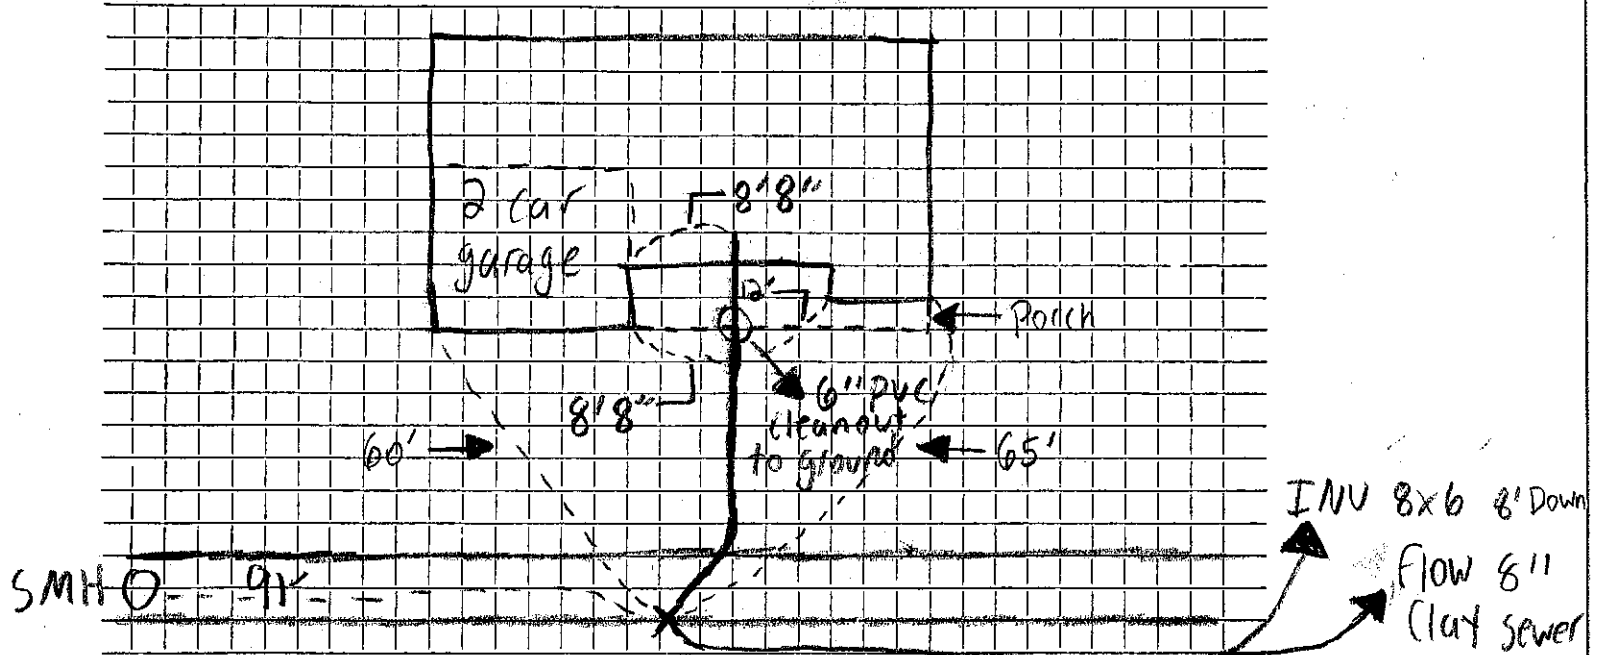

Connection made in 74 Oak St Street. Work completed J. M. McLaughlin Inc

Remarks: