

Name **Elisabeth Schwarz**

Service No. **22**

Address **77 Oak Street**

**Lexington, Mass. 77 Oak St.** Location **77 Oak Street**

Kind of Pipe

Size **6"**

Size of Main **8"**

~~XXXXXXXXXX~~ New Service Com. **June 27, 1949**

Location

Date	Material	Amount	Total	Date	Amount
Apr 6, '49	Labor	51 63	51 63	April 25 '49	90 00
	10% Overhead		5 16	June 30 '49	2 00
	3/4" - 6" Sewer Pipe @.27		9 18		88 00
	1 - 6" 1/8 Band		1 49		
	Joint Compound		2 04		
	Littlefield Shovel 1 hr. @7.00		7 00		
	Trucking 2 hrs. @.75		1 50		
	Patching 10 x 3		10 00		
			88 00		
	Labor				

**TOWN OF LEXINGTON—DEPT. OF PUBLIC WORKS**  
**SEWER DIVISION**

DATE .....

NO. ....


The undersigned applies for the construction of a particular sewer connecting No. ....  
Street and hereby agrees to comply with the Rules and Regulations governing the construction **and** use of Particular  
Sewers, as now or at any future time established by the Board of Selectmen.

Am't of estimate \$.....

Am't Paid \$.....

..... Owner

**Sketch of Service Here**

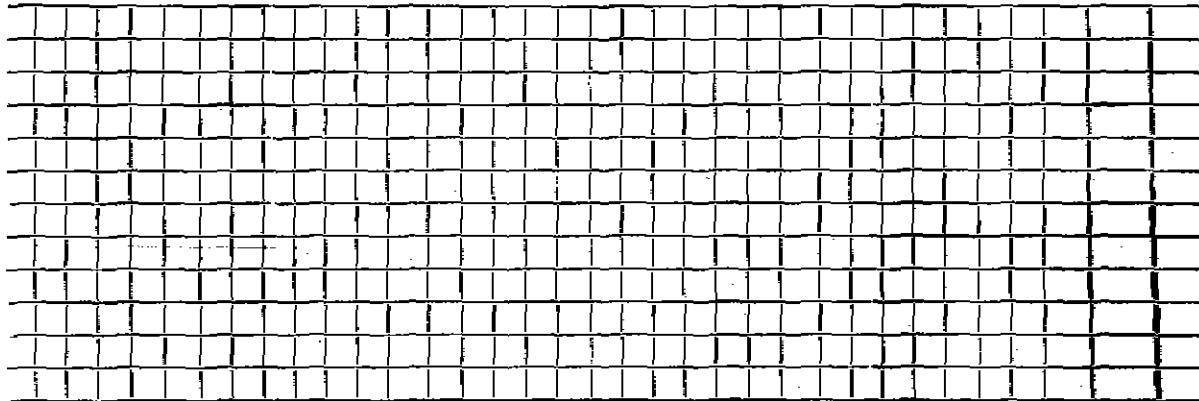

Connection made in ..... Street.

Work completed ..... 19..

Remarks: