

200 Oak Street

20 Oak St.

Kind of Pipe	Size 6"	Size of Main 8"	Number—Amount—New Service	Location	Date	Total	Date	Amount
Date	Material	Amount	Total	Date	Amount			
9-24-24	50' 6" Sewer Pipe @.30	9 00						
9-27-24	10' 4" Iron Pipe @.50	5 00		Oct. 14 1929	Cash			
1	1/8" Bend	70						
	Sulphur & Jute	1 20						
	Trucking	75	16 65					
9-17-29	Hrs. Labor @.55	32 45						
3	" @.60	1 80	34 25					
	15% Overhead		5 12					
	Labor		56 00					

TOWN OF LEXINGTON—BOARD OF PUBLIC WORKS

SEWER DIVISION

DATE _____

NO. _____


The undersigned applies for the construction of a particular sewer connecting No. _____
Street and hereby agrees to comply with the Rules and Regulations governing the construction and use of Particular
Sewers, as now or at any future time established by the Board of Selectmen.

Am't. of Estimate \$ _____

Am't. Paid \$ _____

Owner

Sketch of Service Here

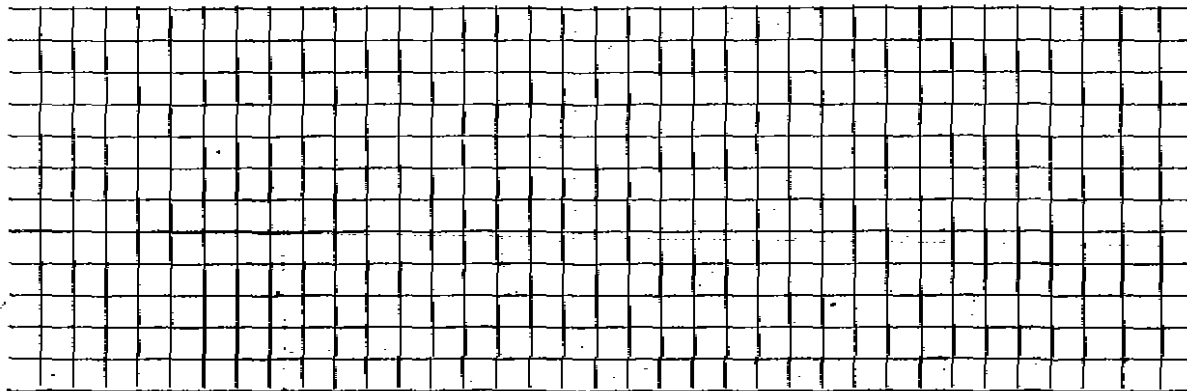

Connection made in _____ Street.

Work completed _____ 19

Remarks: